



Compliance Inspection Form

Existing Subsurface Sewage Treatment Systems (SSTS)

Doc Type: Compliance and Enforcement

Inspection results based on Minnesota Pollution Control Agency (MPCA) requirements and attached forms – additional local requirements may also apply.

Submit completed form to Local Unit of Government (LUG) and system owner within 15 days

For local tracking purposes:

System Status

System status on date (mm/dd/yyyy): 4/28/2016

Compliant – Certificate of Compliance
(Valid for 3 years from report date, unless shorter time frame outlined in Local Ordinance.)

Noncompliant – Notice of Noncompliance
(See Upgrade Requirements on page 3.)

Reason(s) for noncompliance (check all applicable)

- Impact on Public Health (Compliance Component #1) – Imminent threat to public health and safety
- Other Compliance Conditions (Compliance Component #3) – Imminent threat to public health and safety
- Tank Integrity (Compliance Component #2) – Failing to protect groundwater
- Other Compliance Conditions (Compliance Component #3) – Failing to protect groundwater
- Soil Separation (Compliance Component #4) – Failing to protect groundwater
- Operating permit/monitoring plan requirements (Compliance Component #5) – Noncompliant

Property Information

Parcel ID# or Sec/Twp/Range: 21.029.21.34.0006

Property address: 8335 22nd St N Lake Elmo MN 55042 Reason for inspection: Property Sale

Property owner: Terry Forrest Owner's phone: 612-747-9643

or
Owner's representative: Wade Hanson, Realtor Representative phone: 651-274-8584

Local regulatory authority: Washington County Regulatory authority phone: 651-430-6673

Brief system description: 1,500 gallon septic tank, 1,000 gallon septic tank and gravity, rock trench drainfield.

Comments or recommendations:

RECEIVED

MAY 12 2016

PUBLIC HEALTH

Certification

I hereby certify that all the necessary information has been gathered to determine the compliance status of this system. No determination of future system performance has been nor can be made due to unknown conditions during system construction, possible abuse of the system, inadequate maintenance, or future water usage.

Inspector name: Tom Trooien Certification number: 323

Business name: All State Septic Services LLC License number: 1568

Inspector signature: Phone number: 612-594-4496

Necessary or Locally Required Attachments

- Soil boring logs
- System/As-built drawing
- Forms per local ordinance
- Other information (list): _____

1. Impact on Public Health – Compliance component #1 of 5

Compliance criteria:

| | |
|---|---|
| System discharges sewage to the ground surface. | <input type="checkbox"/> Yes <input checked="" type="checkbox"/> No |
| System discharges sewage to drain tile or surface waters. | <input type="checkbox"/> Yes <input checked="" type="checkbox"/> No |
| System causes sewage backup into dwelling or establishment. | <input type="checkbox"/> Yes <input checked="" type="checkbox"/> No |

Any "yes" answer above indicates the system is an imminent threat to public health and safety.

Comments/Explanation:

Verification method(s):

- Searched for surface outlet
- Searched for seeping in yard/backup in home
- Excessive ponding in soil system/D-boxes
- Homeowner testimony (See Comments/Explanation)
- "Black soil" above soil dispersal system
- System requires "emergency" pumping
- Performed dye test
- Unable to verify (See Comments/Explanation)
- Other methods not listed (See Comments/Explanation)

2. Tank Integrity – Compliance component #2 of 5

Compliance criteria:

| | |
|--|---|
| System consists of a seepage pit, cesspool, drywell, or leaching pit. <i>Seepage pits meeting 7080.2550 may be compliant if allowed in local ordinance.</i> | <input type="checkbox"/> Yes <input checked="" type="checkbox"/> No |
| Sewage tank(s) leak below their designed operating depth. If yes, which sewage tank(s) leaks: | <input type="checkbox"/> Yes <input checked="" type="checkbox"/> No |

Any "yes" answer above indicates the system is failing to protect groundwater.

Comments/Explanation:

Verification method(s):

- Probed tank(s) bottom
- Examined construction records
- Examined Tank Integrity Form (Attach)
- Observed liquid level below operating depth
- Examined empty (pumped) tanks(s)
- Probed outside tank(s) for "black soil"
- Unable to verify (See Comments/Explanation)
- Other methods not listed (See Comments/Explanation)

3. Other Compliance Conditions – Compliance component #3 of 5

- a. Maintenance hole covers are damaged, cracked, unsecured, or appear to be structurally unsound. Yes* No Unknown
- b. Other issues (electrical hazards, etc.) to immediately and adversely impact public health or safety. Yes* No Unknown
***System is an imminent threat to public health and safety.**

Explain:

- c. System is non-protective of ground water for other conditions as determined by inspector. Yes* No
***System is failing to protect groundwater.**

Explain:

4. Soil Separation – Compliance component #4 of 5

Date of installation: 6/25/1996 Unknown
(mm/dd/yyyy)

Shoreland/Wellhead protection/Food beverage lodging? Yes No

Compliance criteria:

For systems built prior to April 1, 1996, and not located in Shoreland or Wellhead Protection Area or not serving a food, beverage or lodging establishment: Yes No

Drainfield has at least a two-foot vertical separation distance from periodically saturated soil or bedrock.

Non-performance systems built April 1, 1996, or later or for non-performance systems located in Shoreland or Wellhead Protection Areas or serving a food, beverage, or lodging establishment: Yes No

Drainfield has a three-foot vertical separation distance from periodically saturated soil or bedrock.*

"Experimental", "Other", or "Performance" systems built under pre-2008 Rules; Type IV or V systems built under 2008 Rules (7080.2350 or 7080.2400 (Advanced Inspector License required) Yes No

Drainfield meets the designed vertical separation distance from periodically saturated soil or bedrock.

Verification method(s):

Soil observation does not expire. Previous soil observations by two independent parties are sufficient, unless site conditions have been altered or local requirements differ.

- Conducted soil observation(s) (Attach boring logs)
- Two previous verifications (Attach boring logs)
- Not applicable (Holding tank(s), no drainfield)
- Unable to verify (See Comments/Explanation)
- Other (See Comments/Explanation)

Comments/Explanation:

Indicate depths or elevations

| | |
|--|----------|
| A. Bottom of distribution media | 30-36 |
| B. Periodically saturated soil/bedrock | n/a |
| C. System separation | 36" plus |
| D. Required compliance separation* | 36" |

*May be reduced up to 15 percent if allowed by Local Ordinance.

Any "no" answer above indicates the system is failing to protect groundwater.

5. Operating Permit and Nitrogen BMP* – Compliance component #5 of 5 Not applicable

Is the system operated under an Operating Permit? Yes No If "yes", A below is required

Is the system required to employ a Nitrogen BMP? Yes No If "yes", B below is required

BMP = Best Management Practice(s) specified in the system design


If the answer to both questions is "no", this section does not need to be completed.

Compliance criteria

- a. Operating Permit number: n/a Yes No
Have the Operating Permit requirements been met?
- b. Is the required nitrogen BMP in place and properly functioning? Yes No

Any "no" answer indicates Noncompliance.

Upgrade Requirements (Minn. Stat. § 115.55) An imminent threat to public health and safety (ITPHS) must be upgraded, replaced, or its use discontinued within ten months of receipt of this notice or within a shorter period if required by local ordinance. If the system is failing to protect ground water, the system must be upgraded, replaced, or its use discontinued within the time required by local ordinance. If an existing system is not failing as defined in law, and has at least two feet of design soil separation, then the system need not be upgraded, repaired, replaced, or its use discontinued, notwithstanding any local ordinance that is more strict. This provision does not apply to systems in shoreland areas, Wellhead Protection Areas, or those used in connection with food, beverage, and lodging establishments as defined in law.

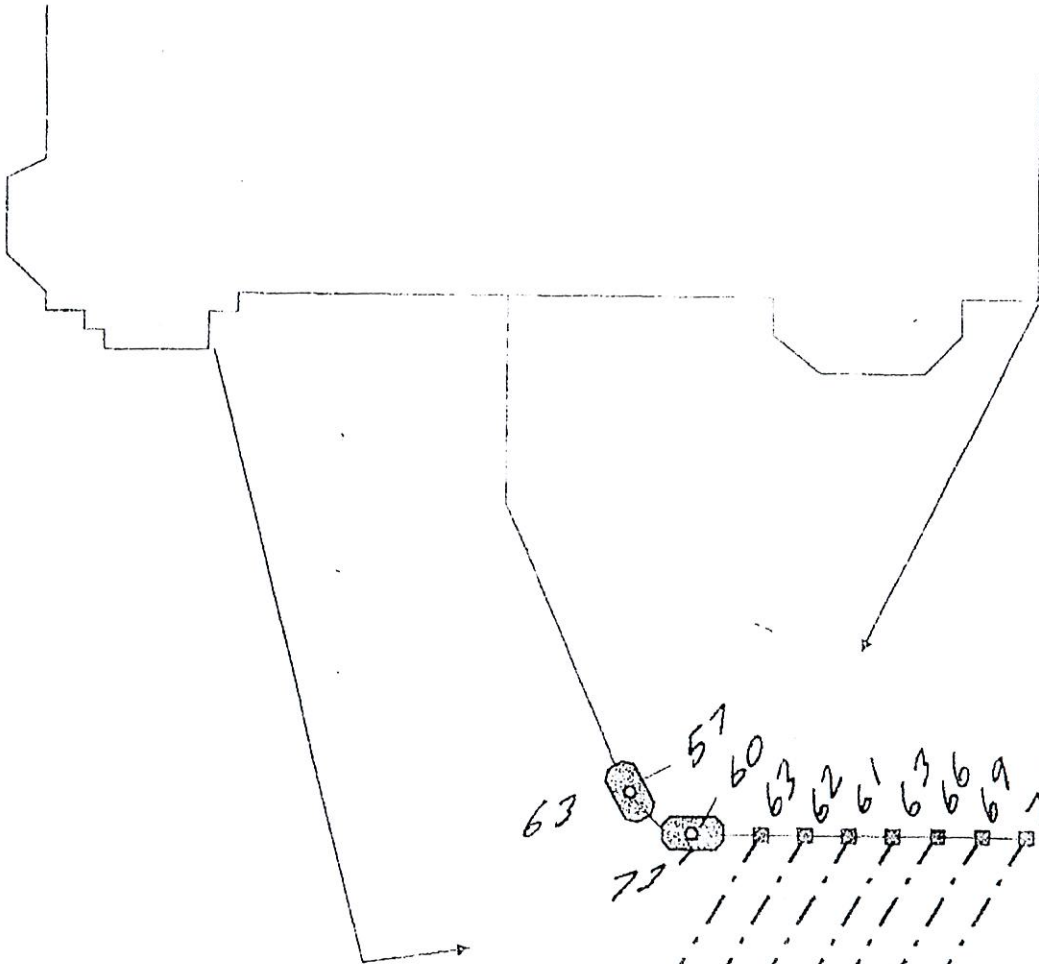

63 57 60 63 62 61 63 66 69 66 73
77
78 86 94 112 120 128 136

Logs of Soil Borings

Location or Project 8335 22nd Street N
 Borings made by Inspect MN Date 1-10-06
 Classification System: AASHO ; USDA-SCS ; Unified ; other
 Auger used (check two): Hand , or Power ; Flight , or Bucket ; other

| Depth, in feet | Boring number <u>B-1</u> Surface elevation <u>Same as lowest trench</u> | Depth, in feet | Boring number <u> </u> Surface elevation <u> </u> |
|----------------|--|----------------|--|
| 0 | | 0 | |
| 1 | 0"-18" 10YR 3/2 Clay loam (topsoil) | 1 | |
| 2 | 18"-50" 7.5YR 4/6 Clay loam w/ some silt layers | 2 | |
| 3 | | 3 | |
| 4 | | 4 | |
| 5 | 48"-78" 7.5YR 4/6 Sandy Clay loam | 5 | |
| 6 | | 6 | |
| 7 | | 7 | |
| 8 | | 8 | |

End of Boring at: 78 Inches
 Mottled Soil Present: Yes NO
 Mottled Soil at: Inches
 Standing Water Present: Yes NO
 Standing Water Present at: Inches

End of Boring at: Inches
 Mottled Soil Present: Yes NO
 Mottled Soil at: Inches
 Standing Water Present: Yes NO
 Standing Water Present at: Inches

TOP OF DISTRIBUTION MEDIUM AT: INCHES
 BOTTOM OF DISTRIBUTION MEDIUM AT: 36 INCHES


REMARKS:
 WERE SOIL SAMPLES SPRAYED? YES NO

When performing the soil boring (s) relative to this septic system inspection, site evaluation or design, the depth to distinct redoximorphic features (commonly know as "mottled soils") were determined by using the definition for "distinct" as defined in MPCA rules 7080.0020 Subp. 13a. adopted through September 2002: "Distinct" means a soil color that varies from another color by one or more hues, more than two units of value, or more than one unit of chroma.

Mil has been advised through training and conversations with the MPCA that the above procedure for determining redoximorphic features (mottled soils) must be used in all cases; no other definitions will be allowed. The only exceptions would be when the difference in soil colors are attributed to other soil features such as lamellae banding, chelation from tannic acids, calcium carbonates, etc.

9/23/04

| Depth | Notes | Color | Sample |
|-----------|--|--------------|--------|
| 0 to 4" | Dark tanish Brown dilt. clay | 10 YR 4/4 | |
| 4 to 14" | Reddish Brown & tan sandstone | 5 YR 3/4 | |
| 14 to 30" | | | |
| 30 to 40" | Reddish Brown silty loam fine | 5 YR 4/3 | |
| 40 to 60" | yellow Brown silt | 10 YR 5/4 | |
| 60 to 70" | Darkish Reddish Brown silty fine | 5 YR 3/4 | |
| 70 to 78" | Reddish Brown silty fine | 5 YR 4/4 | |
| | | | Stop |

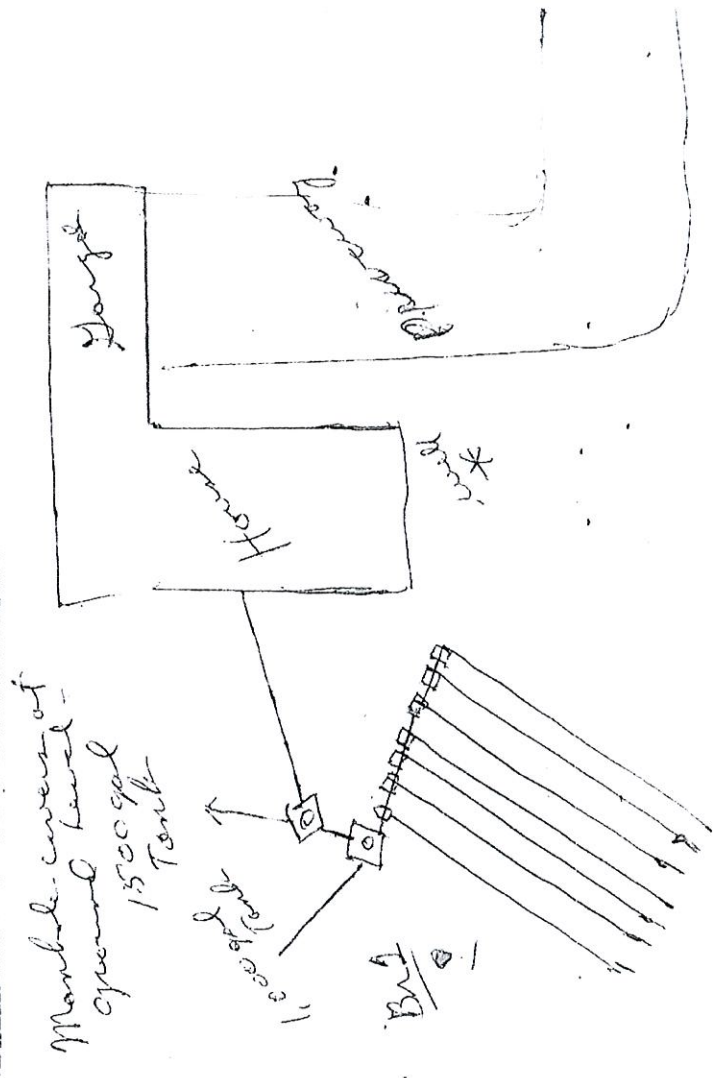

Please note: manhole covers must be secured to prevent unauthorized access to tanks