

520 Lafayette Road North St. Paul, MN 55155-4194

Compliance Inspection Form

Existing Subsurface Sewage Treatment Systems (SSTS)

Doc Type: Compliance and Enforcement


Inspection resurequirements and	ults based on Minnesota Pollution Control Agenc attached forms – additional local requirements m	y (IVII O/ I)	tracking purposes:
	ed form to Local Unit of Government (LUG) a		
System Statu	IS		
System sta	itus on date (mm/dd/yyyy): 9/3/2019		
(Valid for 3	nt – Certificate of Compliance years from report date, unless shorter time ed in Local Ordinance.)	Noncompliant – N (See Upgrade Requireme	otice of Noncompliance nts on page 3.)
Reason(s)	for noncompliance (check all applicable	e)	
	lic Health (Compliance Component #1) – Immin		fety
	Compliance Conditions (Compliance Compone		health and safety
	Integrity (Compliance Component #2) – Failing		
	Compliance Conditions (Compliance Compone		water
	Separation (Compliance Component #4) – Failin ating permit/monitoring plan requirements (Com		mpliant
	and be a second of the second	Phance Component #0) Noncon	приат
Property owner: or	6130 Lamar Ave S Cottage Grove, MN 5501 Kris Mienert	Owner's phone: 65	n: <u>property sale</u> 51-755-6795
Owner's represen		Representative phone	
Local regulatory a Brief system desc			ohone: 651-430-6655
Comments or red		ty drainfield with 10" gravelless pi	pe.
	pumped on August 30, 2019		
Certification			
determination of fa	at all the necessary information has been gather uture system performance has been nor can be the system, inadequate maintenance, or future	made due to unknown conditions	status of this system. No during system construction,
Inspector name:		Certification number:	323
Business name:	All State Septic Services LLC	License number:	1568
Inspector signatur	re: Tom Troown	Phone number:	612-594-4496
Nacces	Lasalla Danisa Lass		
	Locally Required Attachments		
Soil boring log☐ Other informat		Forms per local ordinal	nce
www.pca.state.mn.		TTY 651-282-5332 or 800-657-3864	Available in alternative format Page 1 of

roperty	y address: 6130 Lamar Ave S Cotta	age Grove, MN 55016	Inspector initials/Date: TT 9/3/2019 (mm/dd/yyyy)			
i. Im	pact on Public Health – C	Compliance compon	ent #1 of 5			
Co	ompliance criteria:		Verification method(s):			
	stem discharges sewage to the bund surface.	☐ Yes ☒ No	 ✓ Searched for surface outlet ✓ Searched for seeping in yard/backup in home 			
	stem discharges sewage to drain or surface waters.	☐ Yes ⊠ No	 ☑ Excessive ponding in soil system/D-boxes ☐ Homeowner testimony (See Comments/Explanation) 			
	stem causes sewage backup into relling or establishment.	☐ Yes ☒ No	☐ "Black soil" above soil dispersal system ☐ System requires "emergency" pumping			
sy	ny "yes" answer above indi estem is an imminent threat ealth and safety.		☐ System requires emergency pumping ☐ Performed dye test ☐ Unable to verify (See Comments/Explanation) ☐ Other methods not listed (See Comments/Explanation)			
Co	omments/Explanation:					
	nk Integrity - Compliance	component #2 of 5				
Co	ompliance criteria:		Verification method(s):			
	stem consists of a seepage pit, sspool, drywell, or leaching pit.	☐ Yes ☒ No	☐ Probed tank(s) bottom ☐ Examined construction records			
	Seepage pits meeting 7080.2550 may be compliant if allowed in local ordinance.		☐ Examined Tank Integrity Form (Attach)			
	Sewage tank(s) leak below their designed operating depth.		☐ Observed liquid level below operating depth ☐ Examined empty (pumped) tanks(s)			
If y	ves, which sewage tank(s) leaks:		Probed outside tank(s) for "black soil"			
	ny "yes" answer above indi estem is failing to protect gi		☐ Unable to verify (See Comments/Explanation) ☐ Other methods not listed (See Comments/Explanation)			
	mments/Explanation:					
a.	her Compliance Condition Maintenance hole covers are dama					
b.						
	Explain:					
C.	System is non-protective of ground water for other conditions as determined by inspector . Yes* No *System is failing to protect groundwater. Explain:					
		900 457 2944				

www.pca.state.mn.us • 651-296-6300 • 800-657-3864 • TTY 651-282-5332 or 800-657-3864 • Available in alternative formats wq-wwists4-31b • 6/4/14 Page 2 of 3

Property address: 6130 Lamar Ave S Cottage	Inspector initials/Da	nspector initials/Date: TT 8/29/2019				
		(mm/dd/yyyy)				
4. Soil Separation - Compliance of	ompone	nt #4 of 5				
Date of installation: 6/12/2000						
(mm/dd/yyyy)	Unknown		Verification method(s):			
Shoreland/Wellhead protection/Food beverage lodging?	☐ Yes [⊠ No	Soil observation does not expire. observations by two independent unless site conditions have been	t parties are sufficient,		
Compliance criteria:			requirements differ.			
For systems built prior to April 1, 1996, and not located in Shoreland or Wellhead	☐ Yes ☐	□No	☐ Conducted soil observation(s)☐ Two previous verifications (At			
Protection Area or not serving a food, beverage or lodging establishment:			☐ Not applicable (Holding tank(s),			
Drainfield has at least a two-foot vertical			☐ Unable to verify (See Comment			
separation distance from periodically saturated soil or bedrock.			Other (See Comments/Explanati			
Non-performance systems built April 1,	⊠ Yes	□ No	Comments/Explanation:			
1996, or later or for non-performance systems located in Shoreland or Wellhead			B-1 8/29/19			
Protection Areas or serving a food, beverage, or lodging establishment:			0-16 loam	10 YR 3/2		
Drainfield has a three-foot vertical			16-36 silt loam	10 YR 5/4		
separation distance from periodically			36-53 sandy loam	10 YR 4/4		
saturated soil or bedrock.*			53-72 sandy clay loam	7.5 YR 5/6		
"Experimental", "Other", or "Performance"	☐ Yes	□No	Indicate depths or elevation	s		
systems built under pre-2008 Rules; Type IV or V systems built under 2008 Rules (7080. 2350 or 7080.2400 (Advanced Inspector			A. Bottom of distribution media	2.5		
License required)			B. Periodically saturated soil/bedrock	6		
Drainfield meets the designed vertical separation distance from periodically saturated soil or bedrock.			C. System separation	3.5		
			D. Required compliance separation*	3		
Any "no" answer above indicates to failing to protect groundwater. 5. Operating Permit and Nitroger			*May be reduced up to 15 percen Ordinance. ance component #5 of 5	Not applicable		
Is the system operated under an Operating	Permit?	Пу	es No If "yes", A below is req	uired		
Is the system required to employ a Nitroge			es 🛮 No If "yes", B below is req			
BMP = Best Management Practice(s)						
If the answer to both questions is "i						
Compliance criteria						
a. Operating Permit number: _n/a						
Have the Operating Permit requirements been met?			☐ Yes ☐ No			
b. Is the required nitrogen BMP in place	and prope	ning?				
Any "no" answer indicates Nonc	ompliar	ice.				
Upgrade Requirements (Minn. Stat. § 115.55 discontinued within ten months of receipt of this ground water, the system must be upgraded, repis not failing as defined in law, and has at least tits use discontinued, notwithstanding any local of Wellhead Protection Areas, or those used in continued.	notice or wi placed, or its wo feet of a rdinance th	ithin a shorte s use discont lesign soil se at is more sti	r period if required by local ordinance. If th tinued within the time required by local ord paration, then the system need not be upg rict. This provision does not apply to system	e system is failing to protect inance. If an existing system traded, repaired, replaced, or this in shoreland areas		
WWW DC2 state mp us 651,206,6200 8	00 457 294		7/ / [4 202 [222 022 / [2 204			

www.pca.state.mn.us • 651-296-6300 • 800-657-3864 • TTY 651-282-5332 or 800-657-3864 • Available in alternative formats wq-wwists 4-31b • 6/4/14

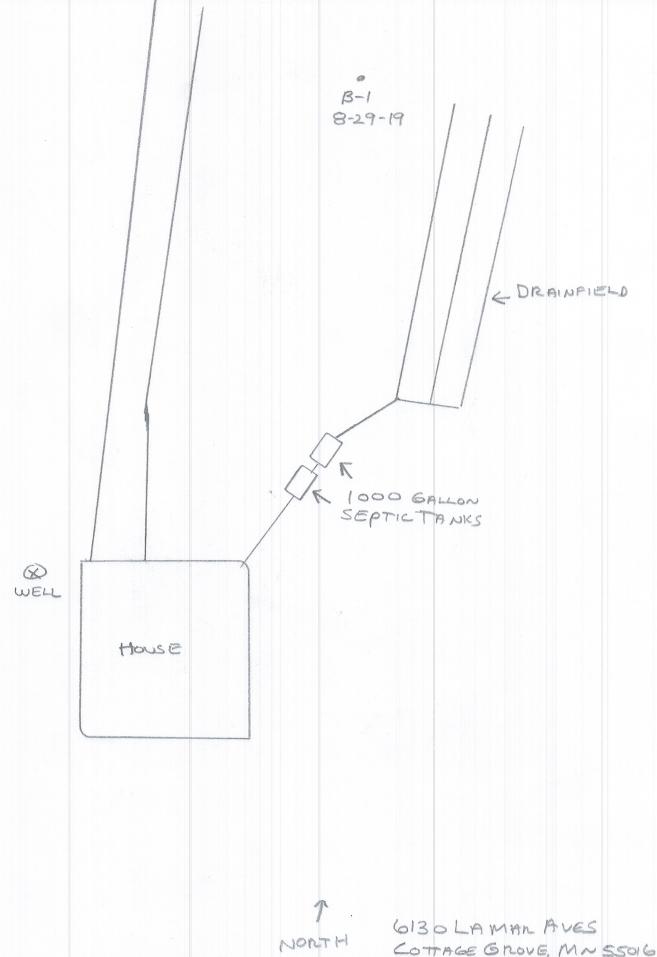

COTTAGE GROVE, MN 55016 8-29-19