


JERRY SAUBER, M.P.C.A. LIC. #925, #317
SAUBER PLUMBING & HEATING CO.
100 THIRD STREET
FARMINGTON, MN 55024 ↑ NORTH
PH: (651) 463-7437 NO SCALE
HM # 463-2597 =

DATE DONE: 4-28-2020
SIGNATURE: *[Signature]*

Marlin Ringeisen —

8087 - Grey Pond Island Drive
St. Paul Park MN.

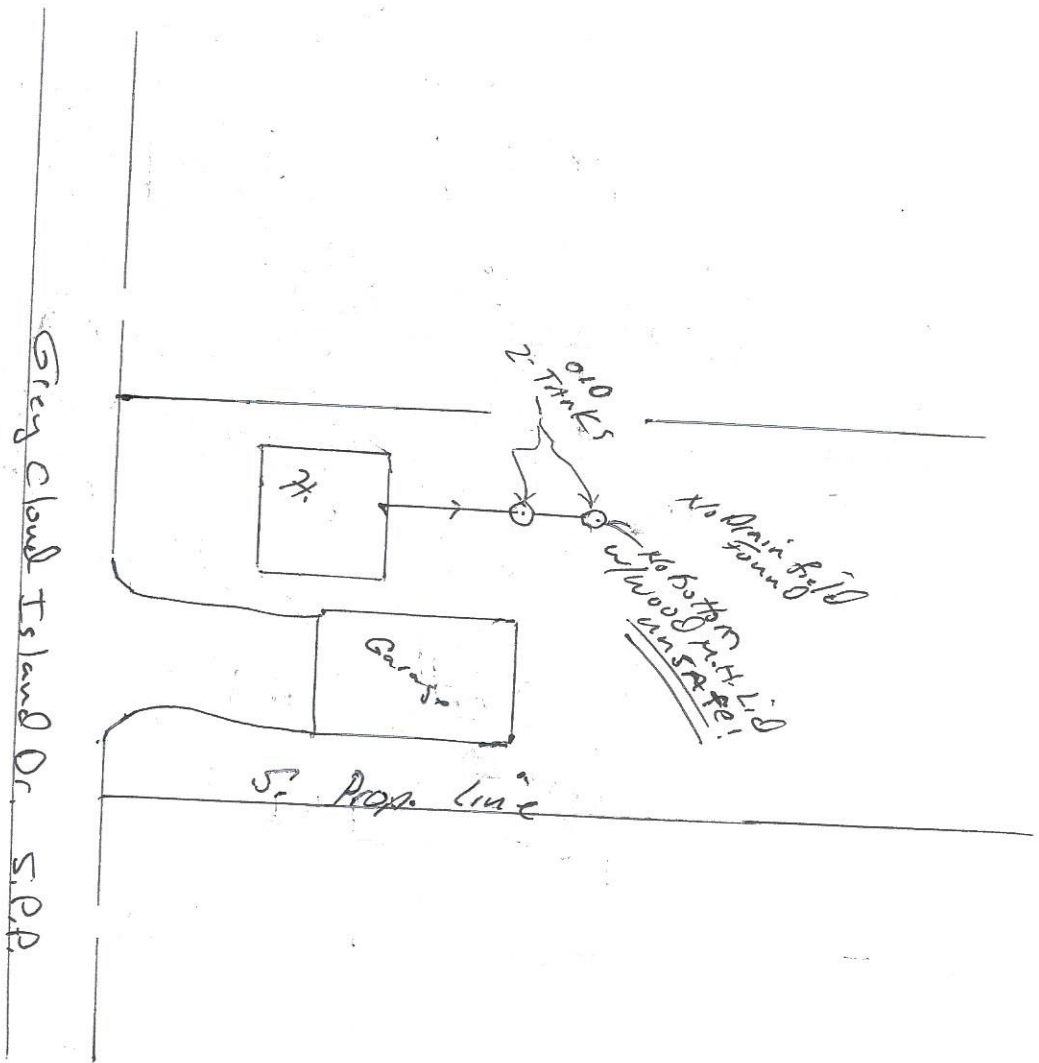

30 Search Maps Tools More...

29 Hide

28 Locate Me

26 Zoom In

25 Zoom Out

23 Full Extent

22 Prev Extent

21 Next Extent

19

18

17

16

140.2

Washington County Maps

Quick Search Identify

1404 1401

Street View Map Themes Map Layers

Print

118

117

GREY CLOUD ISLAND DR S 75


8084

8087

8095

8121

8360

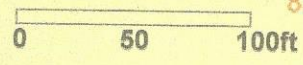

15TH AVE