
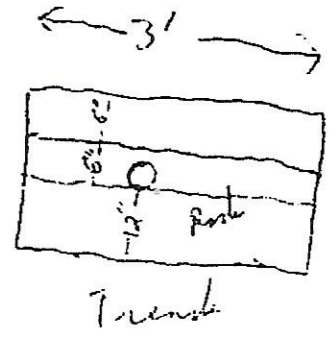


SOIL BORING

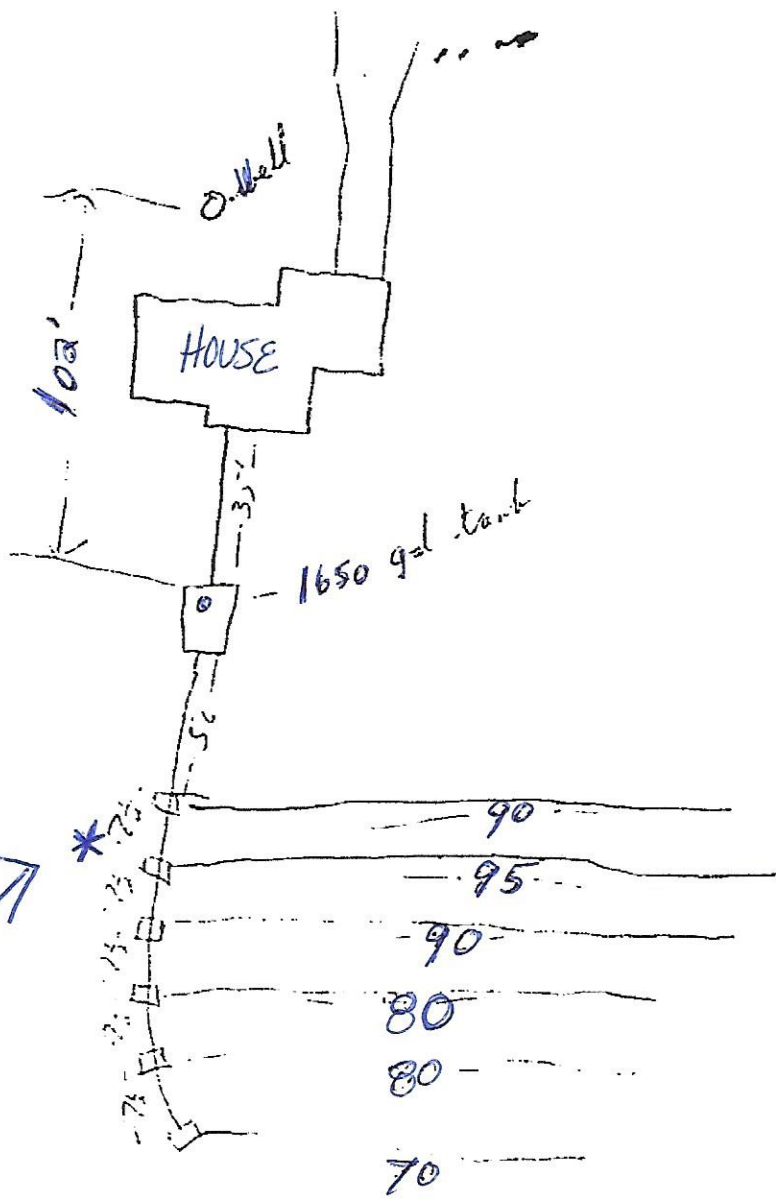

ORIGINAL AS BUILT FROM
8/18/87