


AS BUILT 1983

Site Plans

by Tom Johnson Esq
Tom Johnson
1136-1147

1826 Quartz Hill
Lakeland Blvd

RECEIVED APR 26 1983

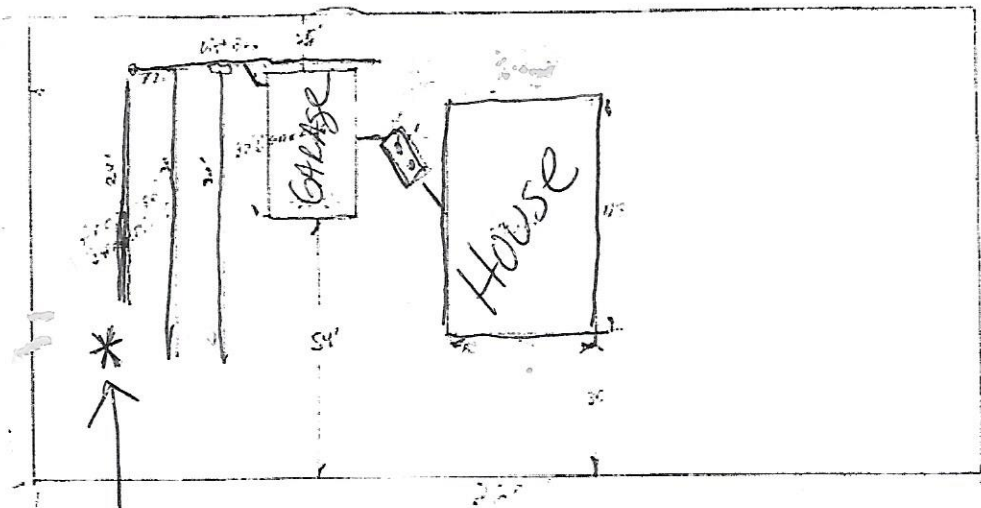

SOIL BORING FOR 2021 INSPECTION

1250 GALLON TANK

DRAINFIELD > 2-30' LINES
1-24' LINE

Hooked to City Water