

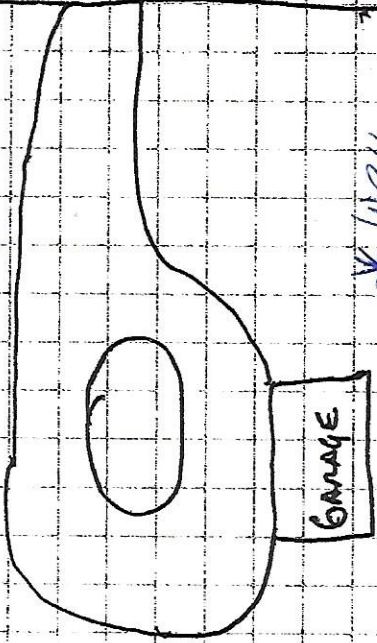


MORGAN AVE SO

GARAGE


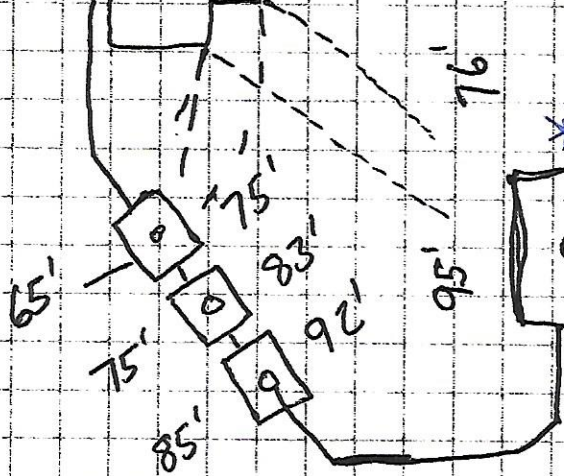


\* WEL

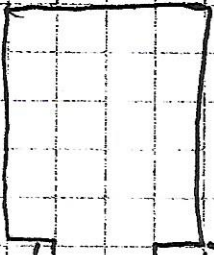

SOIL BARRING

NAT

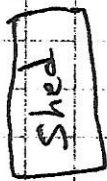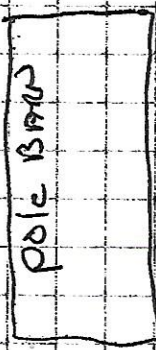

GRIP AND  
PINS



SHED

