


RAMONA



*NOTE - ALL WELLS ARE DEEP OR ARE ANGLE DISTANCE FROM SEWER SYSTEM.

PERMIT # 33-35
CONDITIONALLY APPROVED.
P GANZ 7-12-90

*
SOIL BORING
FOR INSPECTION

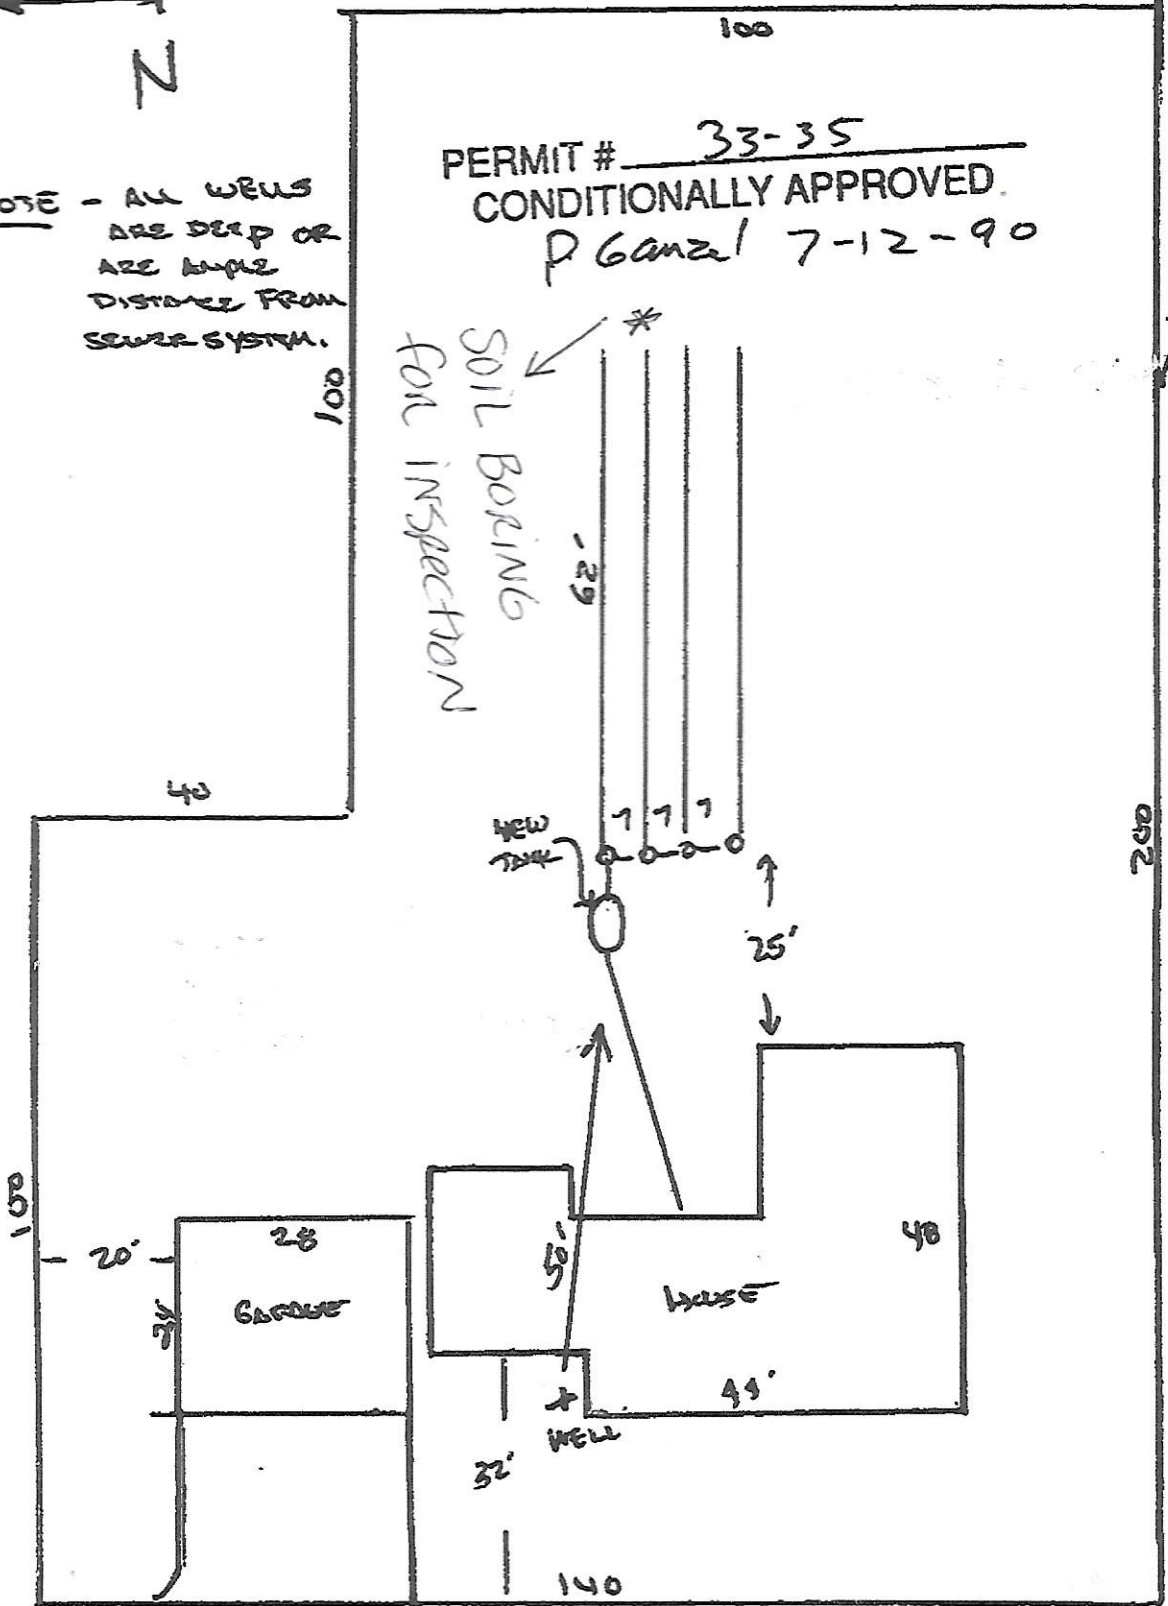

1674 ST