

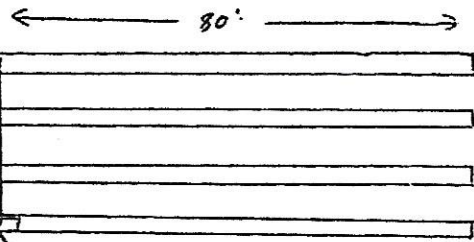


SOIL BORINGS*

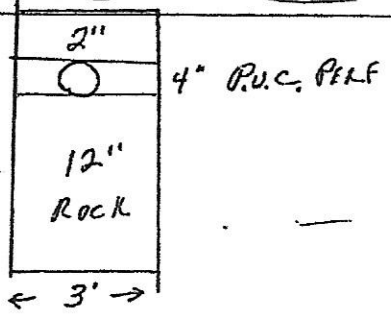


4 - 80' D.F LINES
10' ON CENTER
3' WIDE

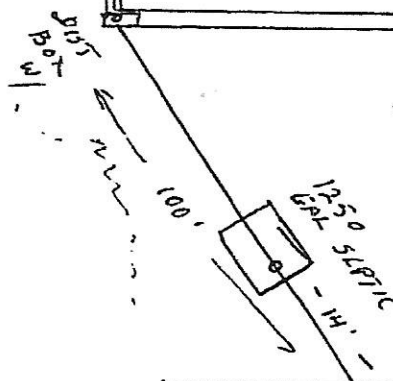

PINK C.

TREES

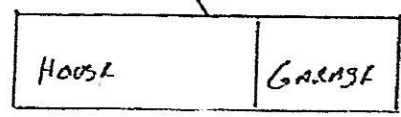

13910 47th St. N.
BAY TOWN