


No Well

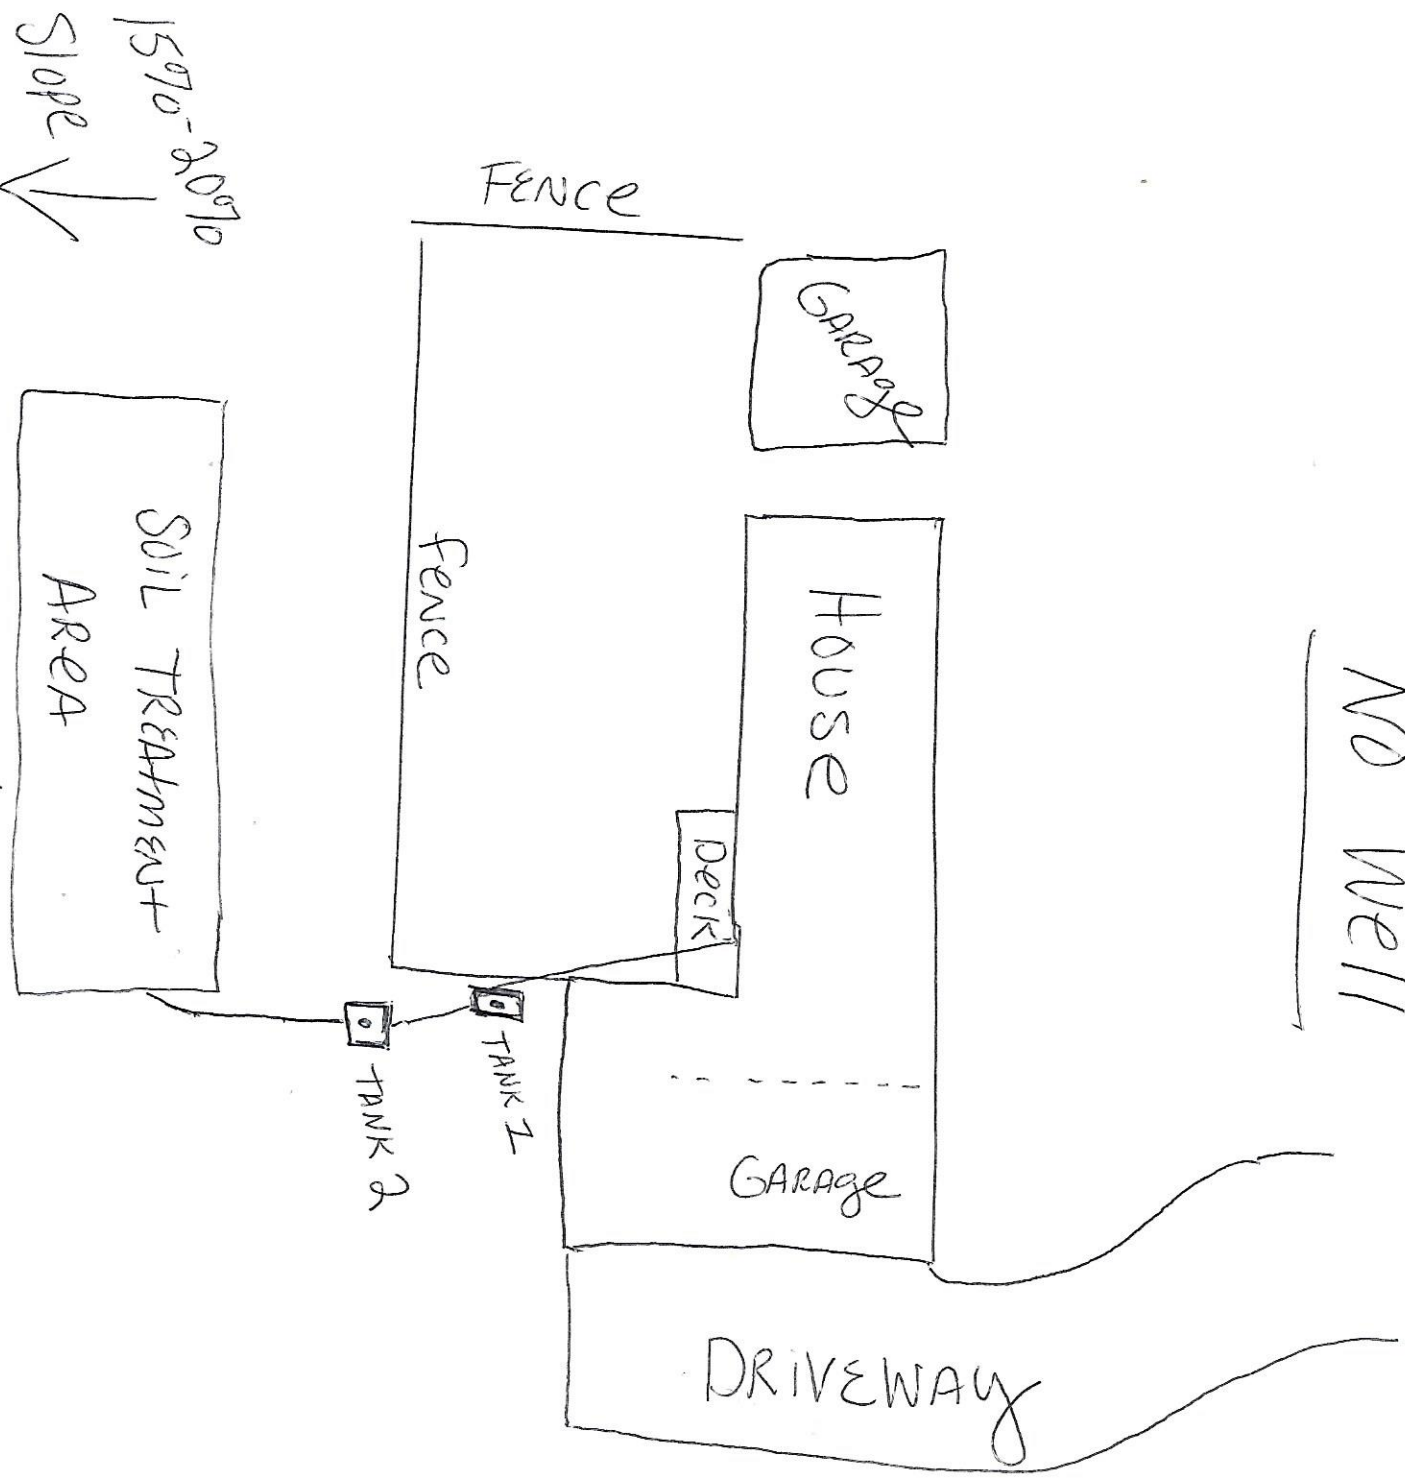

* SOIL BORINGS

TANK 2 manhole
Buried 6"

TANK 1 manhole
Buried 2'