

fence


* SOIL BORING

* WELL

TREE LINE

TREE LINE

1964 SEPTIC TANK

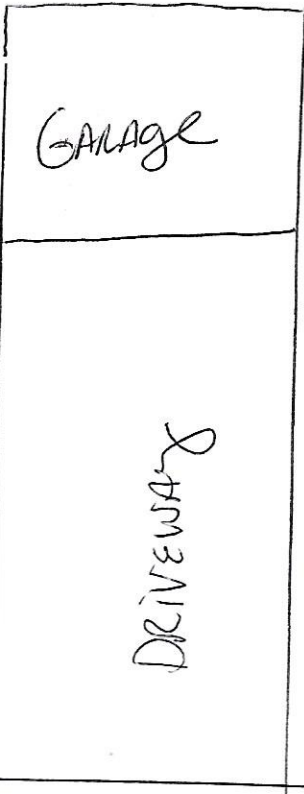

12183 JANERO AVE.

Hugo