


HOME OWNER thought
MAYBE I LINE OFF
TANK but NOT SURE.

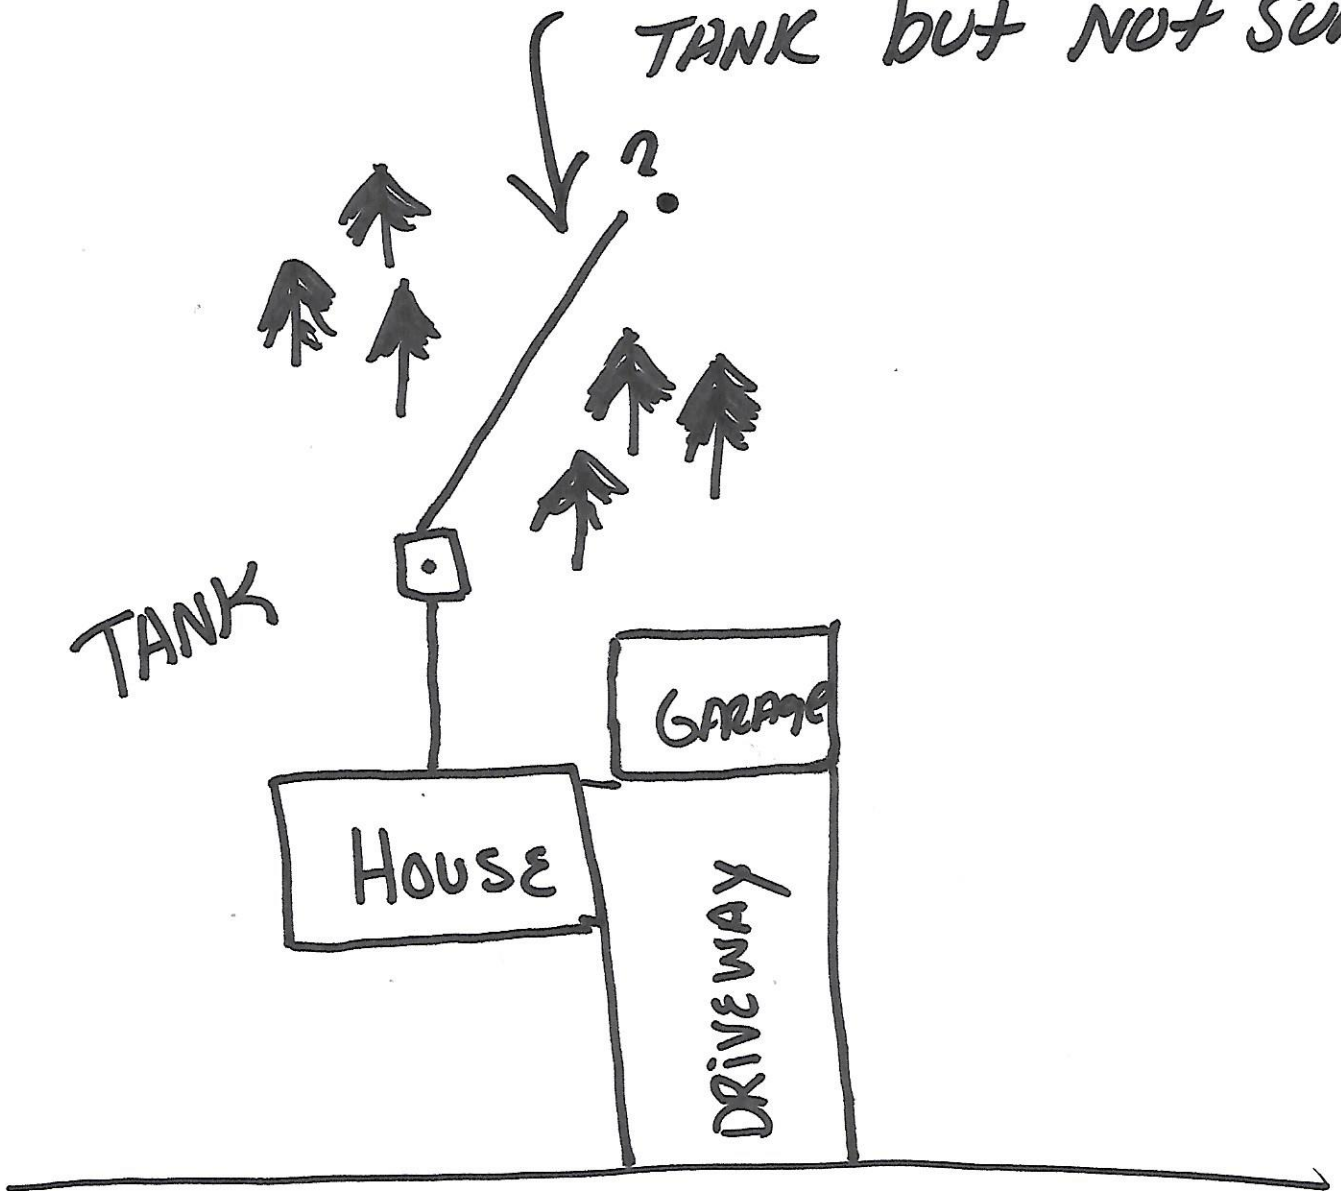

7430 LAMAR AVE.