


NEAL AVE.

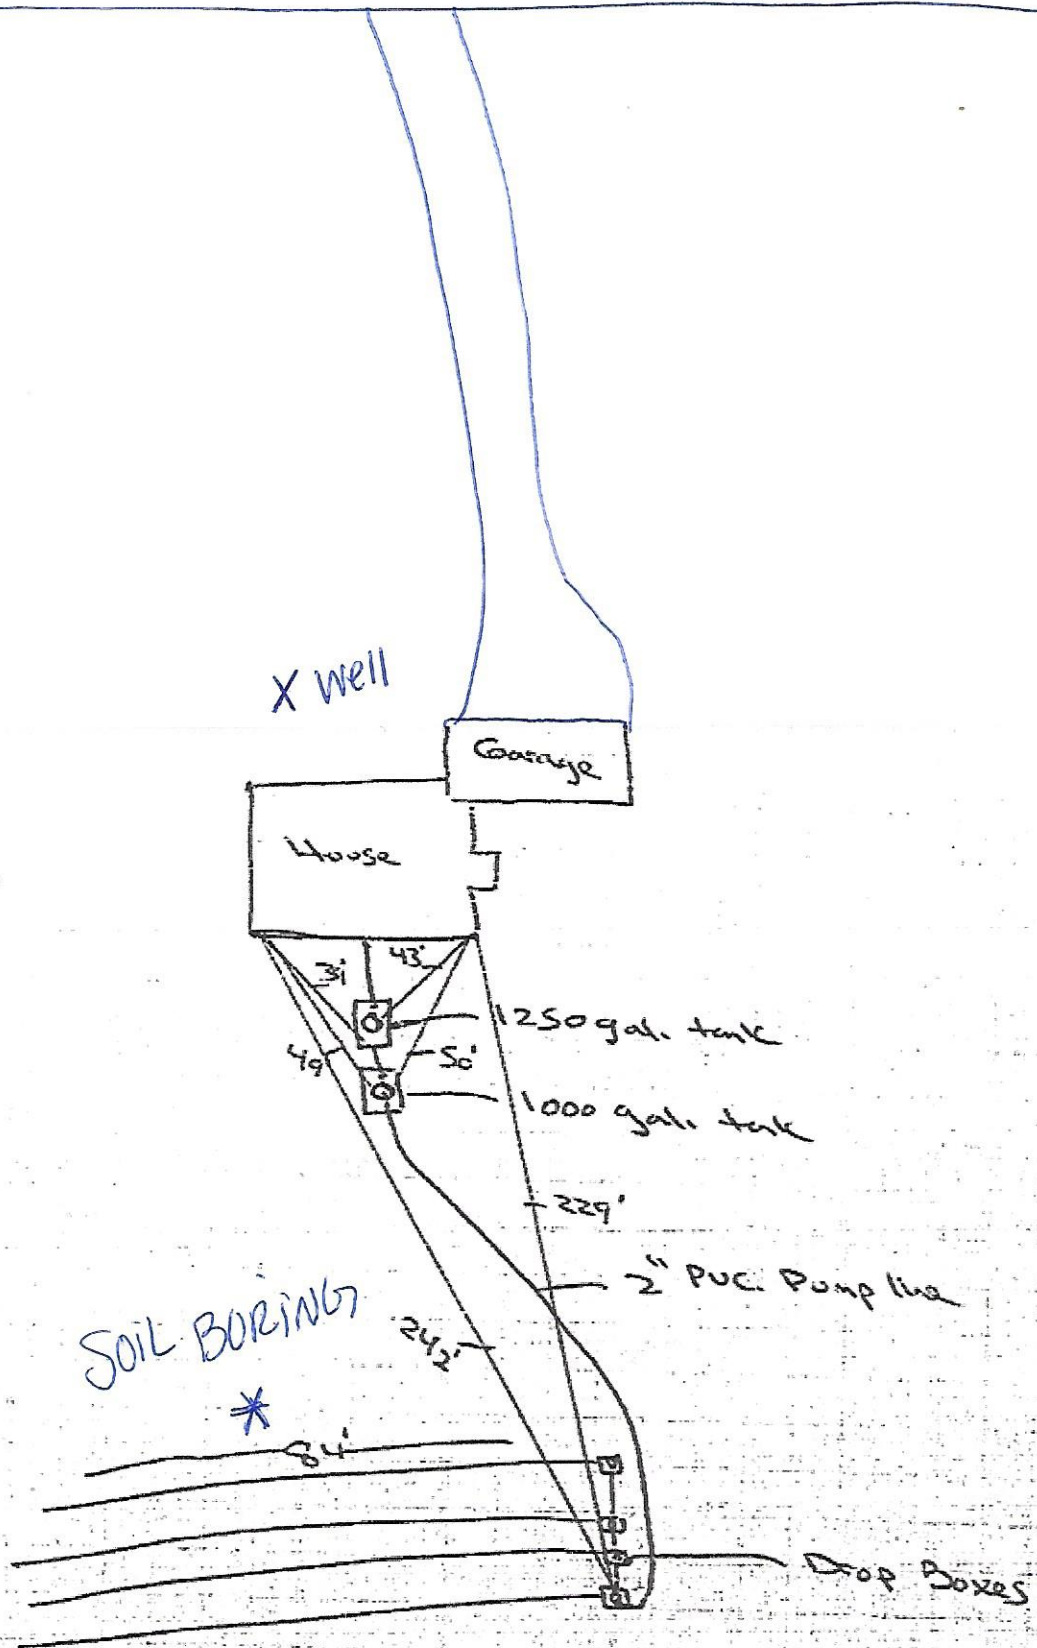

X Well

Garage

House

1250 gal. tank

1000 gal. tank

229'

2" PVC Pump line

SOIL BORINGS

*

242'

84'

Drop Boxes