



Well *

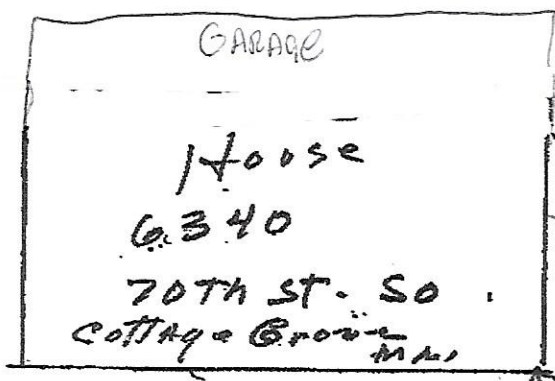

14 FT.

1500 gal

one septic tank with man hole cover to surface

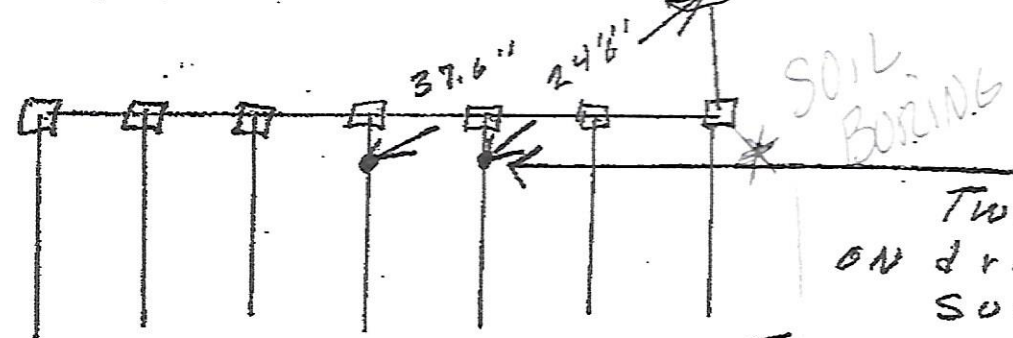

SOIL BORINGS *

Two inspection pipes on drain field to surface

7 drain field lines with rock trench

70th ST