


RECEIVED  
 FEB 26 1998  
 HELLA

*NO 4511131  
 5/22/13*

*8 1/2" soil boring  
 5/22/13*

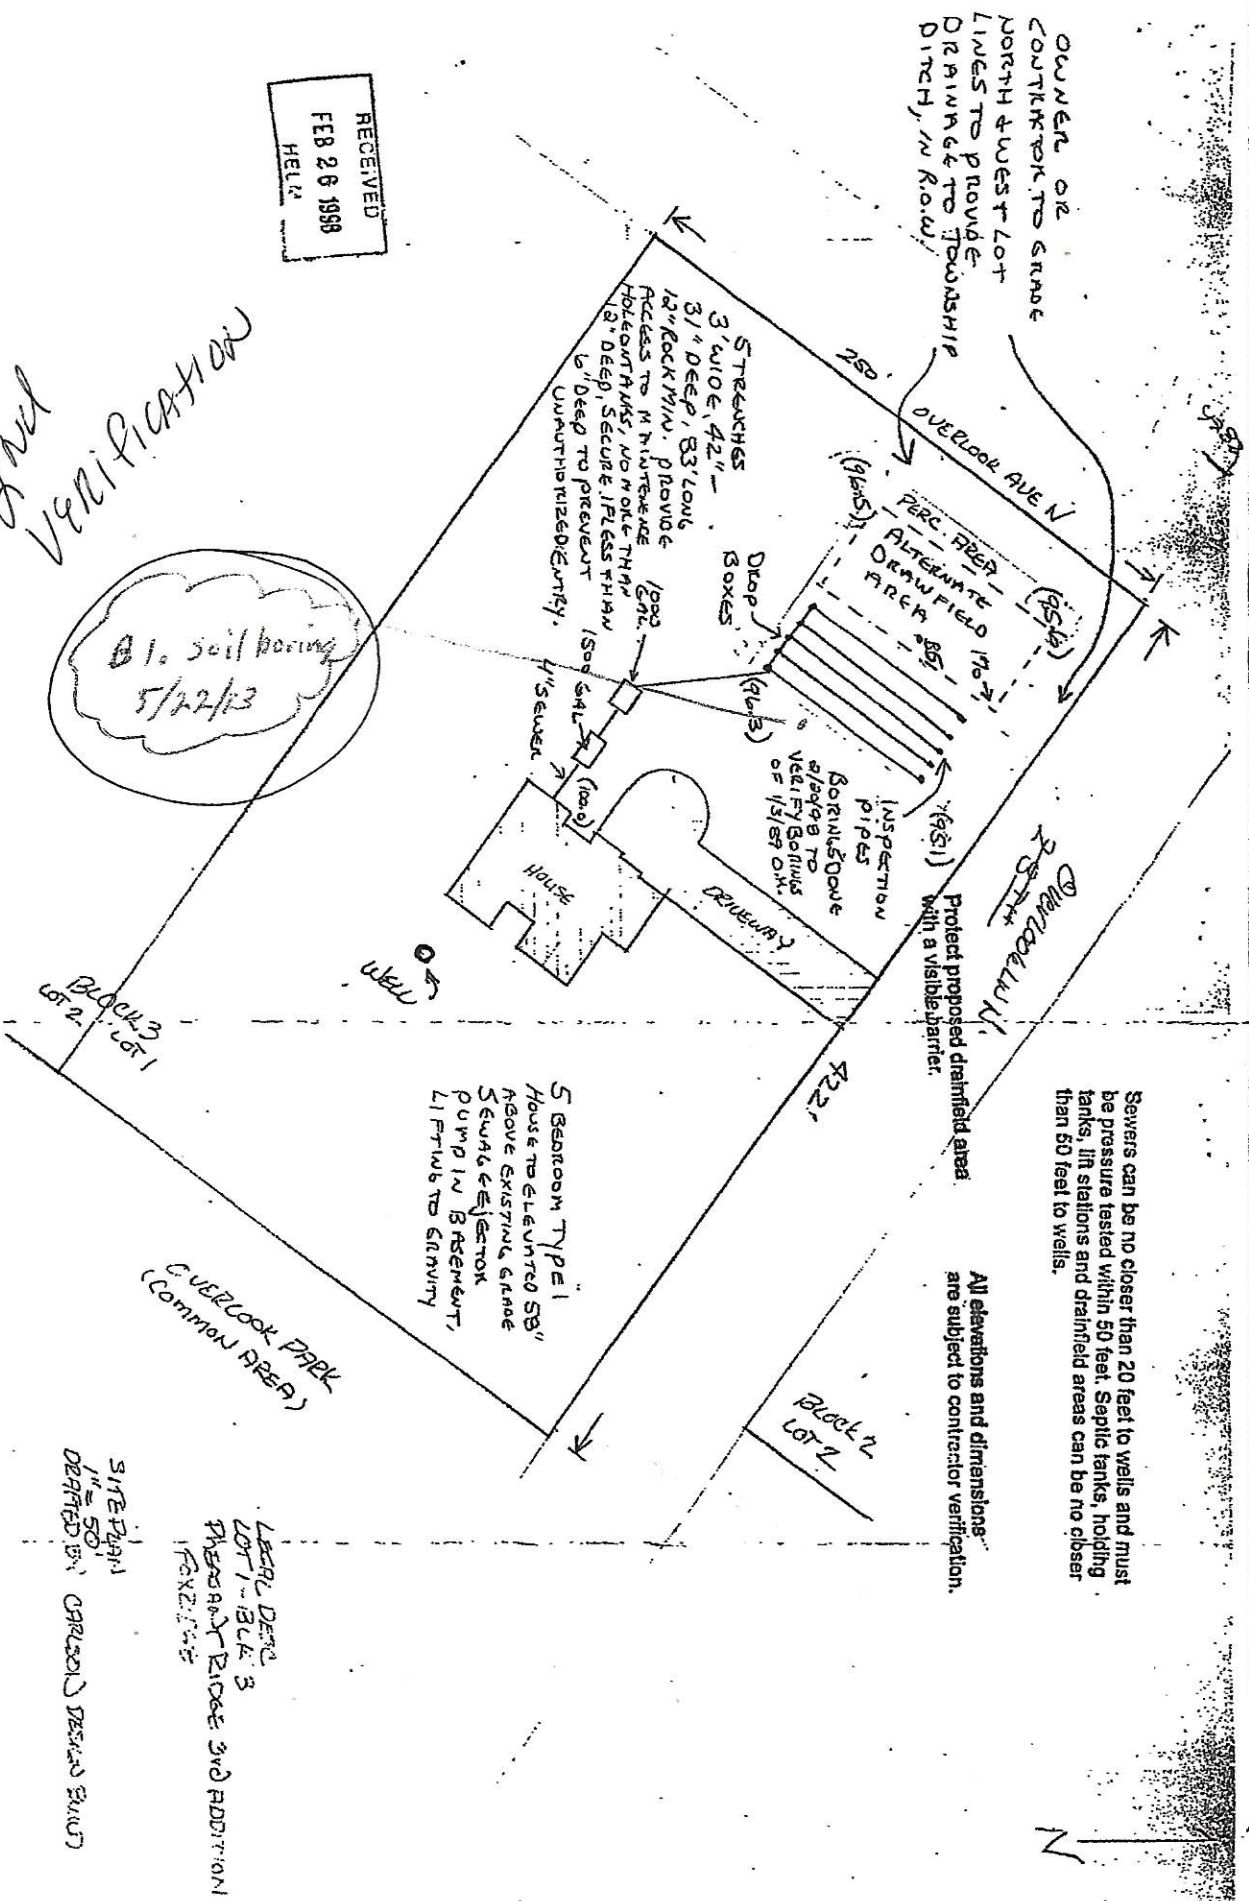

OWNER OR  
 COURTESY TO GRADE  
 NORTH WEST LOT  
 LINES TO PROVIDE  
 DRAINAGE TO TOWNSHIP  
 DITCH, IN ROAD

Sewers can be no closer than 20 feet to wells and must be pressure tested within 50 feet. Septic tanks, holding tanks, lift stations and drainfield areas can be no closer than 50 feet to wells.

All elevations and dimensions are subject to contractor verification.

5 Bedroom Type 1  
 House to elevated SB  
 ABOVE EXISTING GRADE  
 Sewage ejector  
 pump in basement,  
 11 FT W to gravity

OVERLOOK PARK  
 (COMMON AREA)

LABOR DESIGN  
 LOT 1 - BLOCK 3  
 PHASE AND BLOCK 3 AND ADDITIONAL  
 PHASES  
 SITE PLAN  
 1" = 50'  
 DRAFTED BY CAROLAN DESIGN GROUP

