

520 Lafayette Road North St. Paul, MN 55155-4194

Compliance Inspection Form

Existing Subsurface Sewage Treatment Systems (SSTS)

Doc Type: Compliance and Enforcement

-								
Inspection results based on Minnesota Pollution Control Agency (requirements and attached forms – additional local requirements may	MPCA) For also apply.	For local tracking purposes:						
Submit completed form to Local Unit of Government (LUG) and within 15 days	system owner							
System Status								
System Status								
System status on date (mm/dd/yyyy): 6/25/2016								
○ Compliant – Certificate of Compliance (Valid for 3 years from report date, unless shorter time frame outlined in Local Ordinance.)	(Valid for 3 years from report date, unless shorter time (See Upgrade Peguiromente en page 3.)							
Reason(s) for noncompliance (check all applicable)								
Impact on Public Health (Compliance Component #1) – Imminent	t threat to public health a	nd potaty						
Other Compliance Conditions (Compliance Component	#3) – Imminent threat to	nublic health and safety						
☐ Tank Integrity (Compliance Component #2) – Failing to	protect groundwater							
Other Compliance Conditions (Compliance Component)	#3) – Failing to protect a	roundwater						
☐ Soil Separation (Compliance Component #4) – Failing to	protect groundwater							
Operating permit/monitoring plan requirements (Complia	ance Component #5) – N	oncompliant						
Property Information Property address: 15326 11 th St S Afton MN 55001 Property owner: Martin Chalupa		C/Twp/Range: 10.028.20.21.0010 Reason for inspection: Property Sale Owner's phone:						
or								
Owner's representative:		Representative phone:						
Local regulatory authority: Washington County	Regulatory auth	Regulatory authority phone: 651-430-6673						
Brief system description: 2 1,000 gallon septic tanks, 1,000 gallon septic	llon pump tank lifting to g	gravity drainfield						
Certification								
hereby certify that all the necessary information has been gathered determination of future system performance has been nor can be ma cossible abuse of the system, inadequate maintenance, or future wat	do due to unknown sond	nnce status of this system. No litions during system construction,						
nspector name:Tom Trooien		nher: 323						
Business name: All State Septic Services LLC	License nun	nber: 1568						
nspector signature:		nber: _612-594-4496						
Vecessary or Locally Required Attachments								
Necessary or Locally Required Attachments	D-							
Necessary or Locally Required Attachments ☐ Soil boring logs ☐ Other information (list):	☐ Forms per local or	rdinance						

Co	mpliance criteria:		Verification method(s):			
Sys	stem discharges sewage to the und surface.	☐ Yes ⊠ No	 ☑ Searched for surface outlet ☑ Searched for seeping in yard/backup in home 			
Sys	stem discharges sewage to drain or surface waters.	☐ Yes ☒ No	 ☒ Excessive ponding in soil system/D-boxes ☒ Homeowner testimony (See Comments/Explanation) 			
	stem causes sewage backup into elling or establishment.	☐ Yes ⊠ No	☐ "Black soil" above soil dispersal system ☐ System requires "emergency" pumping			
sy	ny "yes" answer above indic estem is an imminent threat ealth and safety.		☐ Performed dye test ☐ Unable to verify (See Comments/Explanation) ☐ Other methods not listed (See Comments/Explanation)			
Co	mments/Explanation:					
. Ta	nk Integrity – Compliance	component #2 of 5				
Co	ompliance criteria:		Verification method(s):			
	stem consists of a seepage pit, sspool, drywell, or leaching pit.	☐ Yes ☒ No	☑ Probed tank(s) bottom☑ Examined construction records			
Se	epage pits meeting 7080.2550 may be	1	☐ Examined Tank Integrity Form (Attach)			
	unitions if allowed in lead ordinance					
COL	mpliant if allowed in local ordinance.		Observed liquid level below operating depth			
cor Se	wage tank(s) leak below their	☐ Yes ☒ No	☐ Observed liquid level below operating depth☐ Examined empty (pumped) tanks(s)			
Se de	ewage tank(s) leak below their signed operating depth.	☐ Yes ⊠ No	1911/1912 - 1919/1919/1919/1919/1919/1919/1919/19			
Se de If y	ewage tank(s) leak below their signed operating depth. yes, which sewage tank(s) leaks:		☐ Examined empty (pumped) tanks(s)			
Se de	ewage tank(s) leak below their signed operating depth. ves, which sewage tank(s) leaks: vey "yes" answer above indi	icates the	☐ Examined empty (pumped) tanks(s)☐ Probed outside tank(s) for "black soil"			
Se de If y	ewage tank(s) leak below their signed operating depth. yes, which sewage tank(s) leaks: ny "yes" answer above indivistem is failing to protect g	icates the	 ☐ Examined empty (pumped) tanks(s) ☐ Probed outside tank(s) for "black soil" ☐ Unable to verify (See Comments/Explanation) 			
Se de If y	ewage tank(s) leak below their signed operating depth. ves, which sewage tank(s) leaks: vey "yes" answer above indi	icates the	 ☐ Examined empty (pumped) tanks(s) ☐ Probed outside tank(s) for "black soil" ☐ Unable to verify (See Comments/Explanation) 			
Se de If y	ewage tank(s) leak below their signed operating depth. yes, which sewage tank(s) leaks: ny "yes" answer above indivistem is failing to protect g	icates the	 ☐ Examined empty (pumped) tanks(s) ☐ Probed outside tank(s) for "black soil" ☐ Unable to verify (See Comments/Explanation) 			
Se de If y	ewage tank(s) leak below their signed operating depth. yes, which sewage tank(s) leaks: ny "yes" answer above indivistem is failing to protect g	icates the	 ☐ Examined empty (pumped) tanks(s) ☐ Probed outside tank(s) for "black soil" ☐ Unable to verify (See Comments/Explanation) 			
Se de If y	ewage tank(s) leak below their signed operating depth. yes, which sewage tank(s) leaks: ny "yes" answer above indivistem is failing to protect g	icates the	☐ Examined empty (pumped) tanks(s)☐ Probed outside tank(s) for "black soil"☐ Unable to verify (See Comments/Explanation)			
See de If y	ewage tank(s) leak below their signed operating depth. ves, which sewage tank(s) leaks: ny "yes" answer above indivistem is failing to protect gromments/Explanation:	icates the roundwater.	 □ Examined empty (pumped) tanks(s) □ Probed outside tank(s) for "black soil" □ Unable to verify (See Comments/Explanation) □ Other methods not listed (See Comments/Explanation) 			
See de lf y Al sy Co	twage tank(s) leak below their signed operating depth. yes, which sewage tank(s) leaks: ny "yes" answer above indivistem is failing to protect gamments/Explanation:	icates the roundwater.	□ Examined empty (pumped) tanks(s) □ Probed outside tank(s) for "black soil" □ Unable to verify (See Comments/Explanation) □ Other methods not listed (See Comments/Explanation)			
Se de lf y AA sy Co	ewage tank(s) leak below their signed operating depth. ves, which sewage tank(s) leaks: ny "yes" answer above indivisem is failing to protect growments/Explanation: ther Compliance Condition Maintenance hole covers are dam	icates the roundwater. ns – Compliance con aged, cracked, unsecur	□ Examined empty (pumped) tanks(s) □ Probed outside tank(s) for "black soil" □ Unable to verify (See Comments/Explanation) □ Other methods not listed (See Comments/Explanation) nponent #3 of 5 ed, or appear to be structurally unsound. □ Yes* ☑ No □ Unknown			
See de lf y Al sy Co	ewage tank(s) leak below their signed operating depth. ves, which sewage tank(s) leaks: ny "yes" answer above indivisem is failing to protect growments/Explanation: ther Compliance Condition Maintenance hole covers are dam	icates the roundwater. ns – Compliance con aged, cracked, unsecure to immediately and adv	□ Examined empty (pumped) tanks(s) □ Probed outside tank(s) for "black soil" □ Unable to verify (See Comments/Explanation) □ Other methods not listed (See Comments/Explanation) nponent #3 of 5 ed, or appear to be structurally unsound. □ Yes* ☒ No □ Unknowersely impact public health or safety. □ Yes* ☒ No □ Unknowersely impact public health or safety. □ Yes* ☒ No □ Unknowersely			
Se de lf y AA sy Co	wage tank(s) leak below their signed operating depth. ves, which sewage tank(s) leaks: ny "yes" answer above indivisem is failing to protect grownents/Explanation: ther Compliance Condition Maintenance hole covers are dam Other issues (electrical hazards, etc.) *System is an imminent threat the	icates the roundwater. ns – Compliance con aged, cracked, unsecure to immediately and adv	□ Examined empty (pumped) tanks(s) □ Probed outside tank(s) for "black soil" □ Unable to verify (See Comments/Explanation) □ Other methods not listed (See Comments/Explanation) nponent #3 of 5 ed, or appear to be structurally unsound. □ Yes* ☒ No □ Unknowersely impact public health or safety. □ Yes* ☒ No □ Unknowersely impact public health or safety. □ Yes* ☒ No □ Unknowersely			
Se de lf y AA sy Co	ther Compliance Condition Maintenance hole covers are dam Other issues (electrical hazards, etc.)	icates the roundwater. ns – Compliance con aged, cracked, unsecure to immediately and adv	□ Examined empty (pumped) tanks(s) □ Probed outside tank(s) for "black soil" □ Unable to verify (See Comments/Explanation) □ Other methods not listed (See Comments/Explanation) nponent #3 of 5 ed, or appear to be structurally unsound. □ Yes* ☒ No □ Unknowersely impact public health or safety. □ Yes* ☒ No □ Unknowersely impact public health or safety. □ Yes* ☒ No □ Unknowersely impact public health or safety. □ Yes* ☒ No □ Unknowersely impact public health or safety.			
Se de lf y AA sy Co	ewage tank(s) leak below their signed operating depth. ves, which sewage tank(s) leaks: ny "yes" answer above indivisem is failing to protect gomments/Explanation: ther Compliance Condition Maintenance hole covers are dam Other issues (electrical hazards, etc.) *System is an imminent threat to Explain:	icates the roundwater. ns – Compliance con aged, cracked, unsecure to immediately and advo public health and sa	□ Examined empty (pumped) tanks(s) □ Probed outside tank(s) for "black soil" □ Unable to verify (See Comments/Explanation) □ Other methods not listed (See Comments/Explanation) nponent #3 of 5 ed, or appear to be structurally unsound. □ Yes* ☒ No □ Unknowersely impact public health or safety. □ Yes* ☒ No □ Unknowersely.			
See de lf y Al sy Co	wage tank(s) leak below their signed operating depth. ves, which sewage tank(s) leaks: ny "yes" answer above indivisem is failing to protect grownents/Explanation: ther Compliance Condition Maintenance hole covers are dam Other issues (electrical hazards, etc.) *System is an imminent threat to Explain:	icates the roundwater. Ins - Compliance con aged, cracked, unsecure to immediately and advo public health and said water for other conditions.	□ Examined empty (pumped) tanks(s) □ Probed outside tank(s) for "black soil" □ Unable to verify (See Comments/Explanation) □ Other methods not listed (See Comments/Explanation) nponent #3 of 5 ed, or appear to be structurally unsound. □ Yes* ☒ No □ Unknowersely impact public health or safety. □ Yes* ☒ No □ Unknowersely.			

Property address: 15326 11th St S Afton MN 55001

Inspector initials/Date: TT | 6/25/2016


operty address: 15326	11th St S Afton MN 5	5001			Inspe	ector initials/Date:	
							(mm/dd/yyyy)
. Soil Separation	n – Compliance co	mpone	nt #4 of 5				
ate of installation:	8/1/2005	Unkr	nown	Verific	ation me	ethod(s):	
(mm/dd/yyyy) Shoreland/Wellhead protection/Food beverage odging? Compliance criteria:		☐ Yes ☑ No		Soil observation does not expire. Previous soil observations by two independent parties are sufficient, unless site conditions have been altered or local requirements differ.			
For systems built prior to April 1, 1996, and not located in Shoreland or Wellhead Protection Area or not serving a food, neverage or lodging establishment:		☐ Yes ☐ No	Conducted soil observation(s) (Attach boring logs)				
				☐ Two previous verifications (Attach boring logs)			
				☐ Not applicable (Holding tank(s), no drainfield)			
				☐ Unable to verify (See Comments/Explanation)			
Orainfield has at least a two-foot vertical separation distance from periodically				Other (See Comments/Explanation)			
aturated soil or bedrock	ζ.						
Non-performance systems built April 1, 1996, or later or for non-performance systems located in Shoreland or Wellhead Protection Areas or serving a food, beverage, or lodging establishment:		⊠ Yes □ No		Comments/Explanation:			
				0-30 med sand10YR 3/3			
				30 41 sand			10YR 3/4
				41-71 sand			10 YR 4/3
eparation distance from	ainfield has a three-foot vertical paration distance from periodically turated soil or bedrock.*			71-80 sandy loam7.5 YR 4/4			
Experimental", "Other", or "Performance" systems built under pre-2008 Rules; Type IV or V systems built under 2008 Rules (7080. 2350 or 7080.2400 (Advanced Inspector License required) Drainfield meets the designed vertical		☐ Yes ☐ No	Indicate depths or elevations				
				2 8897 2720 24	bution media	32" n/a	
			B. Periodically saturated soil/bedrock				
separation distance from periodically					tem separa	36"	
aturated soil or bedrocl	k.					liance separation*	36"
Any "no" answer a ailing to protect g	roundwater.			Ordina	ance.		if allowed by Local Not applicable
	ed under an Operatin			s ⊠ No		', A below is requ	iired
	ed to employ a Nitroge	-		s ⊠ No	If "yes"	', B below is requ	iired
150	nagement Practice(s)		in the system	design			
	, ,	•	CONTRACTOR STATE OF THE STATE O		need to h	e completed	
	oth questions is "	no" tni		00 1106 1			
	oth questions is "	no", tni	occiron do		reca to s		
		no", tnis	3 33011011 43		, , , , , , , , , , , , , , , , , , , ,		
If the answer to b	ria	no", tnis	, cooiion uc				
If the answer to b Compliance crite a. Operating Perr	ria					□ No	
Compliance criter a. Operating Perr Have the Operation	ria mit number: <u>n/a</u>	ents beer	n met?			□No	
Compliance crite a. Operating Perr Have the Oper b. Is the required	ria mit number: <u>n/a</u> ating Permit requirem	ents beer	n met?		☐ Yes	□No	

its use discontinued, notwithstanding any local ordinance that is more strict. This provision does not apply to systems in shoreland areas, Wellhead Protection Areas, or those used in connection with food, beverage, and lodging establishments as defined in law. www.pca.state.mn.us • 651-296-6300 • 800-657-3864 • TTY 651-282-5332 or 800-657-3864 • Available in alternative formats

ground water, the system must be upgraded, replaced, or its use discontinued within the time required by local ordinance. If an existing system is not failing as defined in law, and has at least two feet of design soil separation, then the system need not be upgraded, replaced, or

Inspector initials/Date: TT | 6/25/2016

A WELL

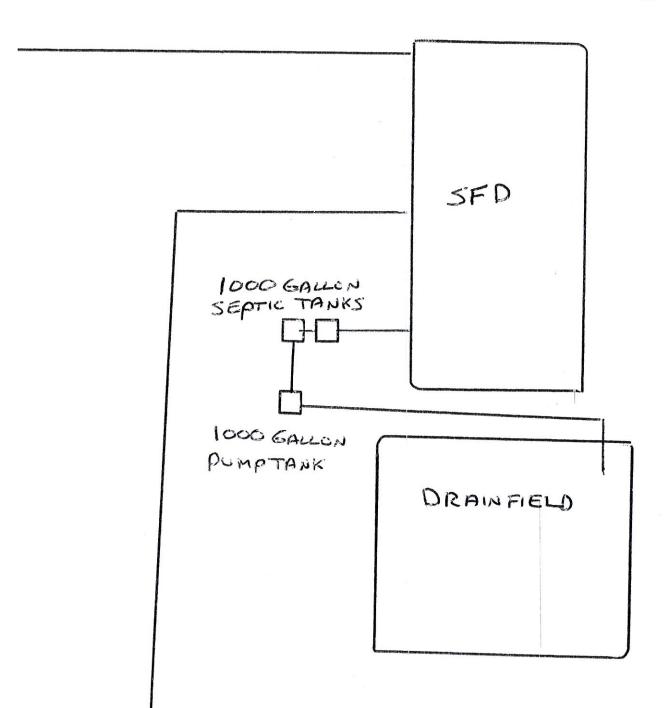

4 1 1 %