


4142 PENFIELD AVE S.

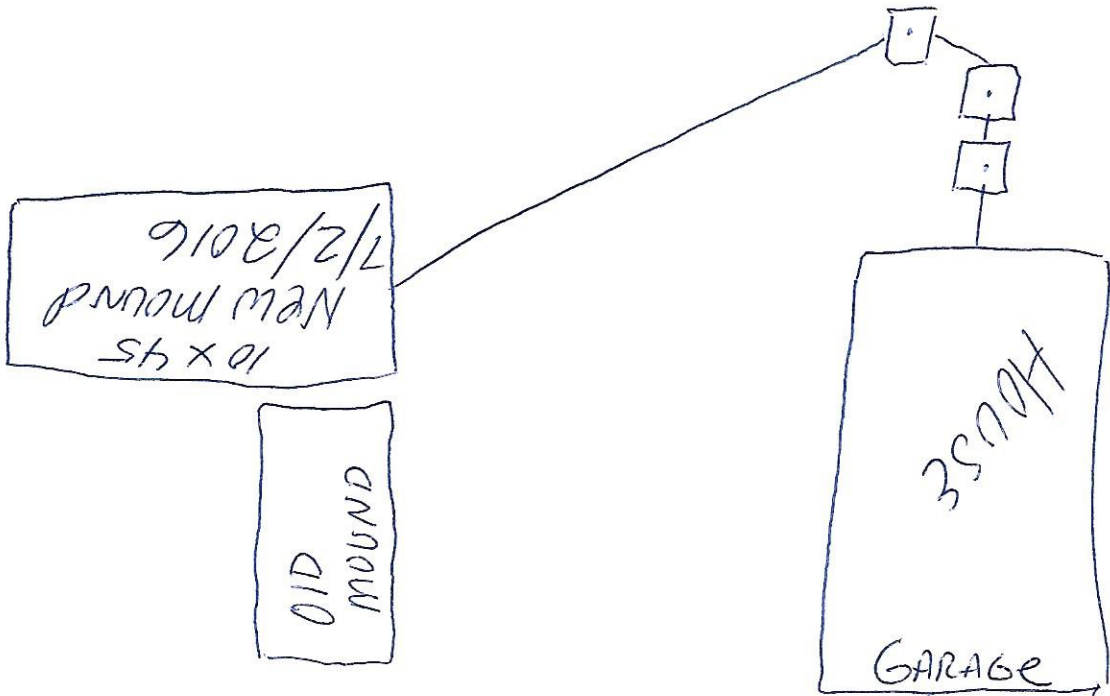

DRIVEWAY

\* Well