

**INDIVIDUAL SEWAGE SYSTEM AS-BUILT**

Owner: Mindugas Voluntas Date Installed: 0-24-16 Permit No. 0320  
 Project Address: Lehigh Ave S Cottage Grove

House Type: Other Property ID No. (PIN): 36-00721-3200-20 (DakCo Tax Info 651-438-4576, or www.co.dakota.mn.us)

City/Twp: Cottage Grove Installed for: 5 Bdrms or 25 gal/day Commercial Use? Y / N

- New  Replace  Repair  Addition
- Property Transfer Upgrade?  Y / N
- Bsmt Lift Pump?  Y  Future?  Y /  N
- Jacuzzi?  Y  Garb Disp?  Y /  N
- Soil Survey Map Unit: 122
- Soil Compacted?  Y /  N
- Fill Soil?  Y /  N

**Circle Soil Texture:**

(Faster than 0.1 m/s)

Coarse Sand

Medium Sand

Loamy Sand 0.83

**FINE SAND 1.67**

Sandy Loam 1.27


Loam 1.67

Silt Loam, Silt 2.00

Sandy Clay Loam 2.2

Silty Clay Loam

Clay 4.2

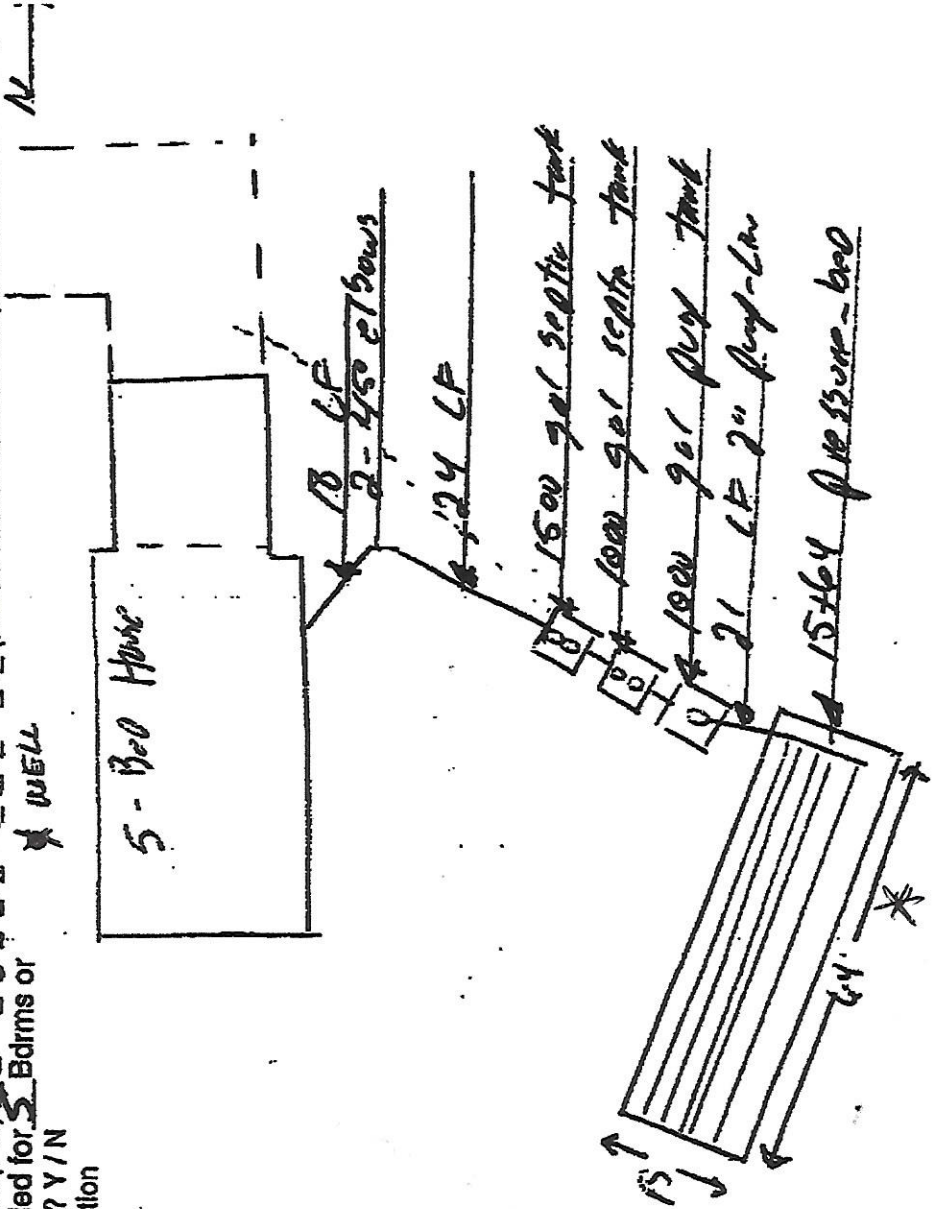

SOIL BORING