


NO well
CITY WATER

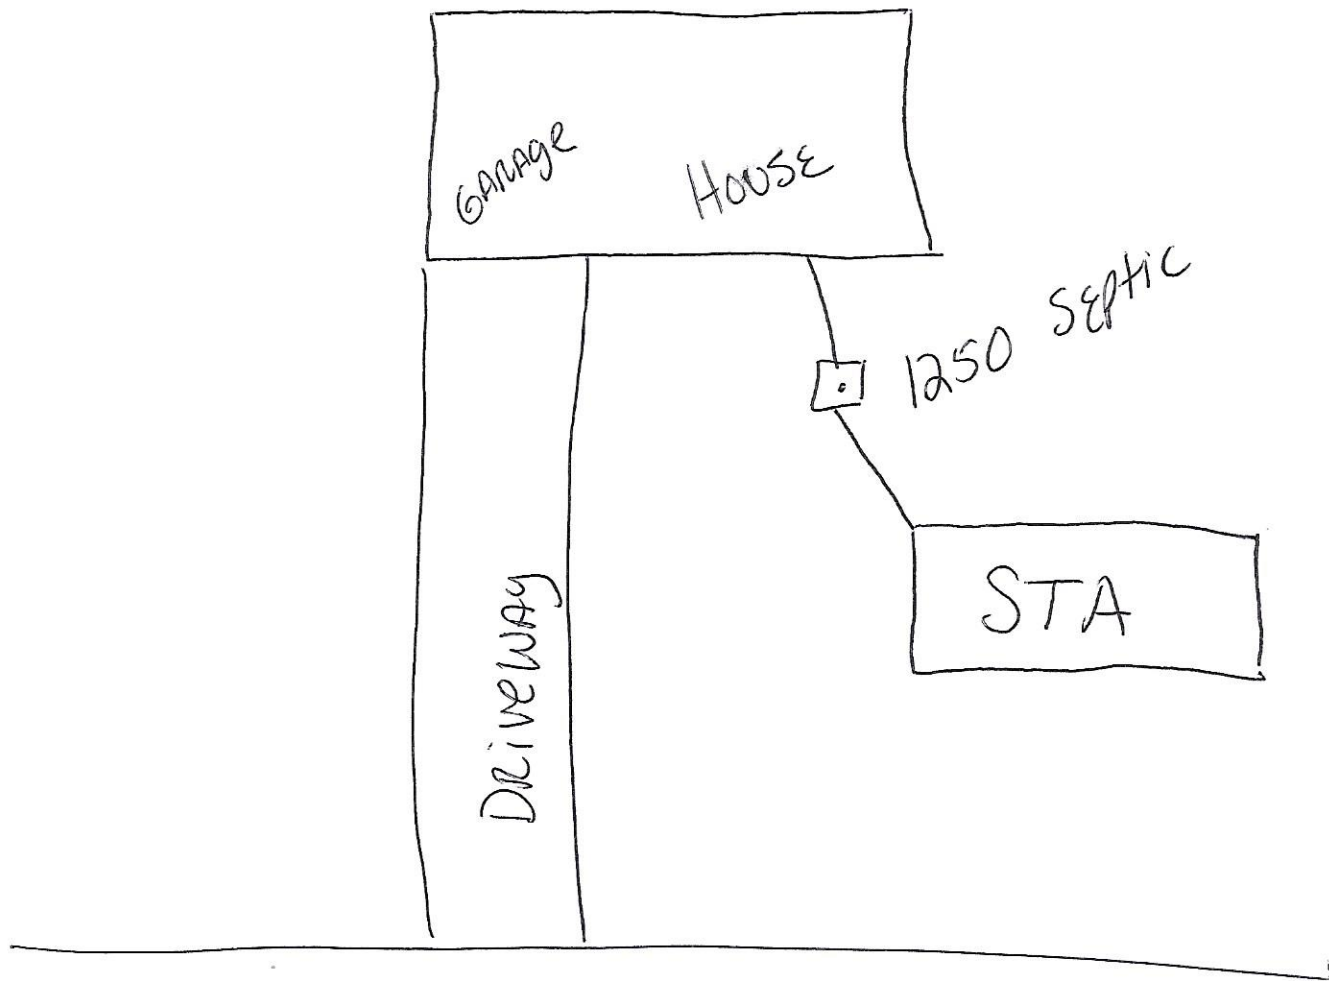

16411 DIVISION ST.