
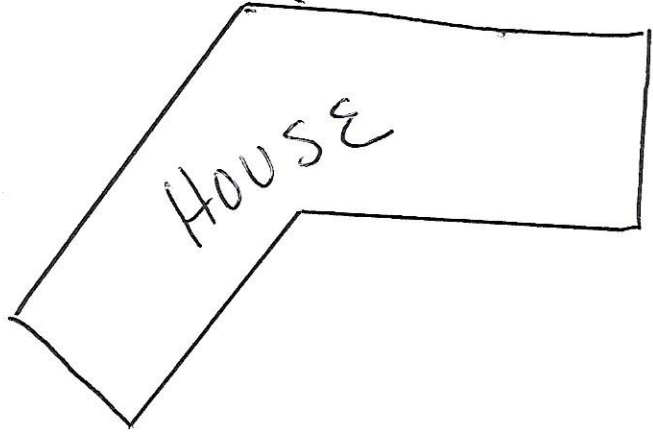
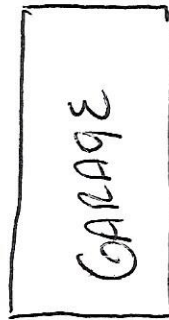


N →

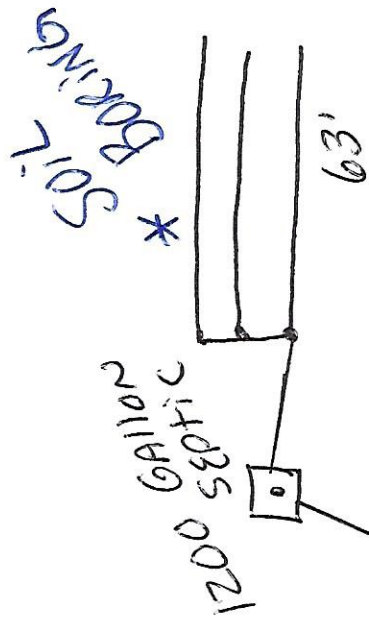

* well

12979 2nd St. S. Afton