


NORTH →

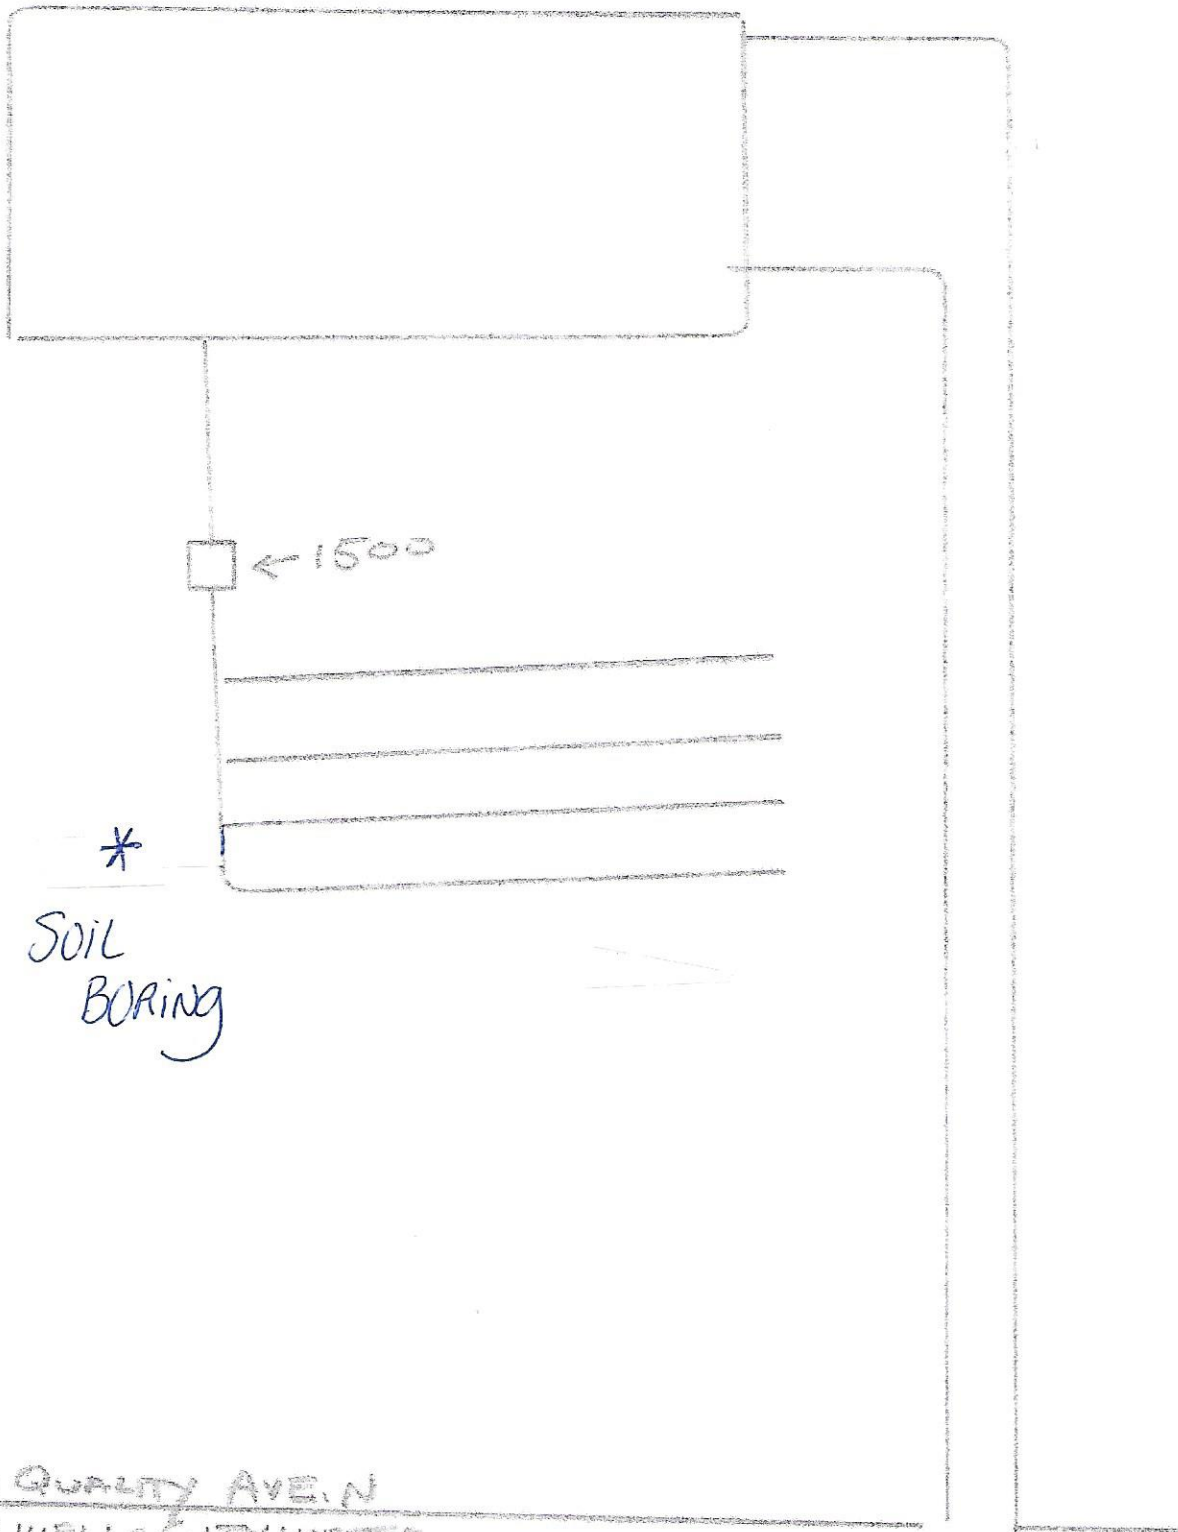

\*  
SOIL  
BORING

98 QUALITY AVE. N  
NO WELL - CITY WATER