

Compliance Boring Log

Date: 1/23/2023

Property Address: 73 APPLE ORCHARD ROAD, DELLWOOD MN 55110

Property Owner name: SUSAN JENSEN


Boring 1		Location:		
Soil Horizons Depth	Color	Texture	Structure	Consistence
0-10"	10YR 3/2	topsoil	Friable	Weak
10-18"	10yr 5/4	Clay	Blocky	Firm
Redox 14"				

Boring 2		Location:		
Soil Horizons Depth	Color	Texture	Structure	Consistence
0-10"	10YR 3/2	topsoil	Friable	Weak
10-26"	10yr 5/4	Clay	Blocky	Firm
Redox 22"				

THIS IS NOT A SURVEY

DATE: 1/23/23

73 APPLE ORCHARD RD, DELLWOOD MN 55110

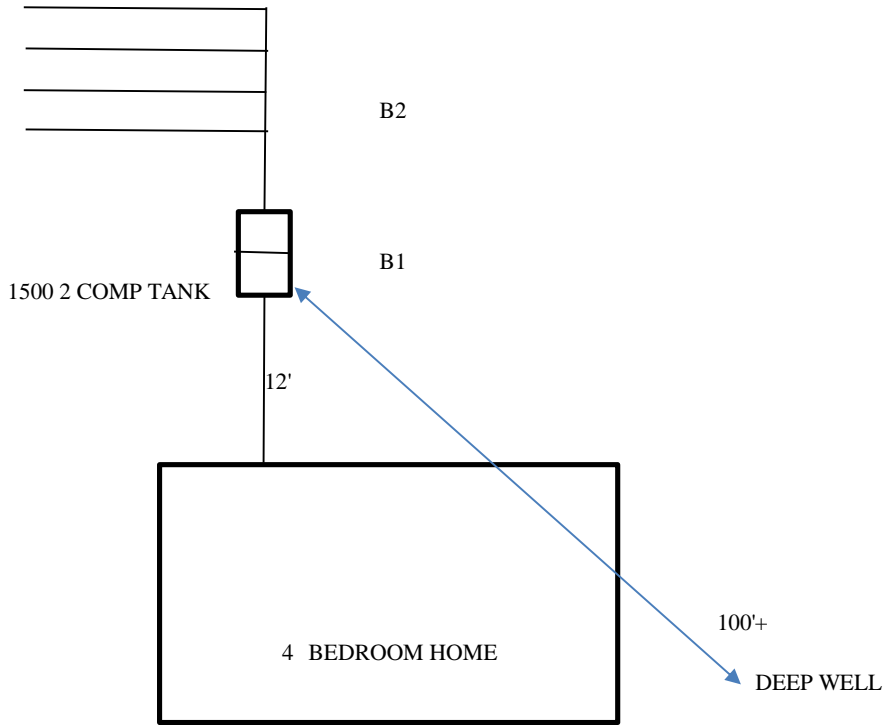

N

