

Compliance Boring Log

Date: 4/24/2023


Property Address: 9139 170th Street N, Hugo MN

Property Owner name: Jeff Peterson

Boring 1 Elevation:		Location:		
Soil Horizons Depth	Color	Texture	Structure	Consistence
0-8	10yr 3/2	Loam	Granular	Friable
8-32"	10yr 5/4	Clay Loam	Granular	Friable
Restrictive @ 24"				

Boring 2 Elevation:		Location:		
Soil Horizons Depth	Color	Texture	Structure	Consistence

Site Evaluation Map

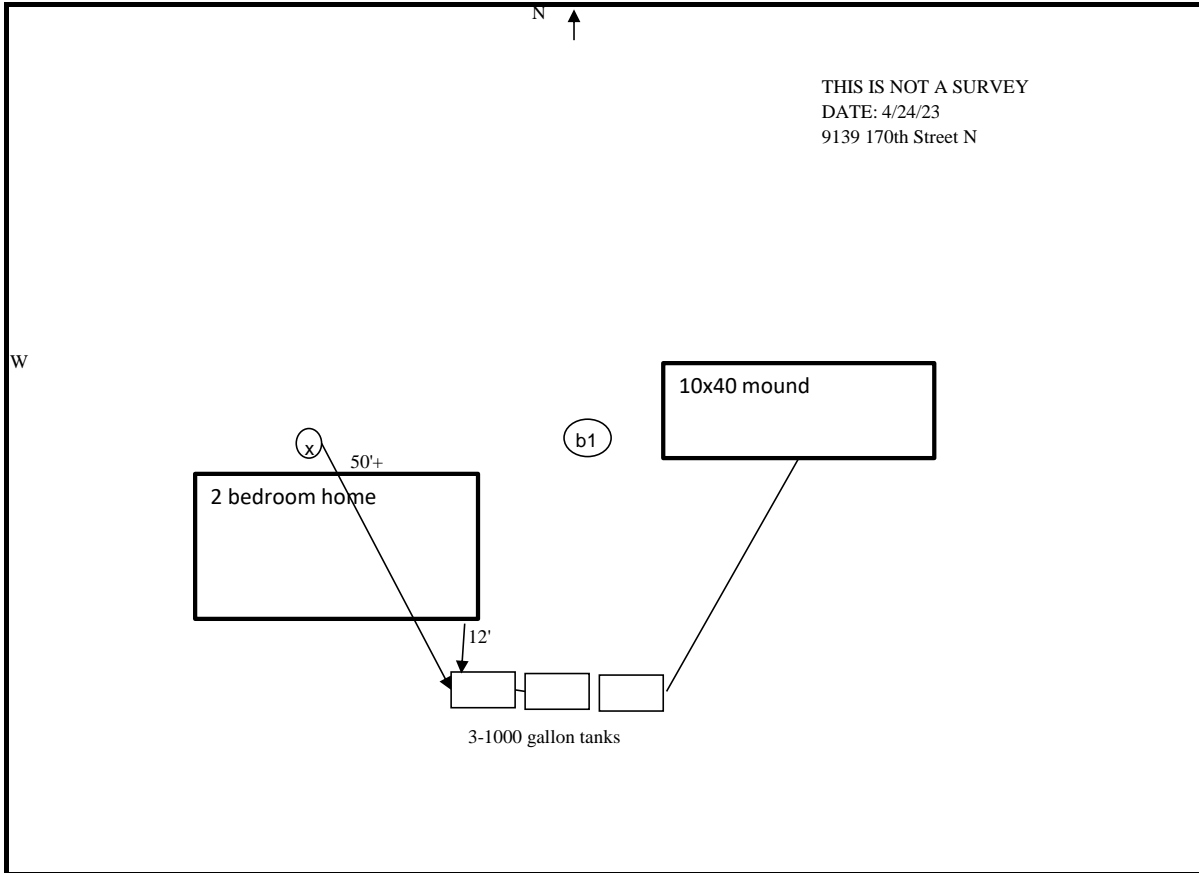

List any construction issues: _____

Mapping Checklist

Map scale: _____ indicate north _____ show slope _____ % direction _____

Locate

- ___ lot dimensions/property lines
- ___ dwellings and other improvements
- ___ existing and/or proposed system(s)
- ___ replacement area
- ___ unsuitable area(s)
- ___ public water supply wells
- ___ pumping access
- ___ inner wellhead zone

Easements

- ___ phone
 - ___ electric
 - ___ gas
- ### Elevations
- ___ borings
 - ___ benchmark
 - ___ perc tests
 - ___ horiz&vert reference pts

Setbacks

- ___ building
- ___ all water wells within 100ft
- ___ pressure pipe
- ___ water suction pipe
- ___ streams, lakes, rivers
- ___ floodway and fringe

I hereby certify this work has been completed in accordance with all applicable ordinances, rules and laws.

_____ (signature) _____ (date)

_____ (license #) _____ (phone number)

