



Minnesota Pollution Control Agency

520 Lafayette Road North
St. Paul, MN 55155-4194

SSTS Abandonment Reporting Form

Subsurface Sewage Treatment Systems (SSTS) Program

Instructions

This form is offered to meet the abandonment requirements of Minn. R. 7080.2500 and Disclosure Requirements of Minn. Stat. § 115.55, subd. 6. Future water supply well placement can also be affected by an abandoned SSTS.

The use of this form is not mandatory; however the information on this form must be submitted to the local government unit (LGU) within 90 days after the abandonment. This form may be completed by a certified SSTS practitioner or by an individual who has direct knowledge of how the system was abandoned.

Property Information

Date of abandonment: 12-12-2016 Reason for abandonment: Hookup to City Sewer

Property owner name(s): Patricia Kennedy

Property owner's address: 1200 Northgate Blvd Stillwater MN

City: Stillwater State: MN Zip: 55082

Site address (if different): Same

City: _____ State: _____ Zip: _____

Compliance Information


- All solids and liquids removed from all tanks? Yes No
Disposal Site: Pinkys Sewer
- All electrical devices and devices containing mercury removed? Yes No
Disposal Site: _____
- All underground sewage tanks crushed and filled with soil or rock material? Yes No or
Removed and disposed off site? Yes No
Disposal Site: _____
- Contaminated materials* removed and disposed off site? Yes No
Disposal Site: Pinkys Sewer
- All underground cavities** crushed and filled with soil or rock material? Yes No or
Removed and disposed off site? Yes No
Disposal Site: _____
- Future discharge to system permanently denied? Yes No
Method(s) used: _____

*Contaminated materials = Distribution media, soil or sand within three feet of the system bottom, distribution pipes, geotextile fabric/rosin paper/straw, tanks, contaminated soil around leaking tanks, any soil that received sewage from a surface failure (7080.2500 subp.3).

**Underground cavities = Cesspools, leaching pits, drywells, seepage pits, vault privies, pit privies, pump chambers (7080.2500 subp. 1). Does not include chamber media, drop boxes, or distribution boxes.

Map

Include location of building sewer, septic tank(s), soil dispersal system, cesspools, seepage pits, and other pits. Also include a permanent reference point(s) and dimensions.

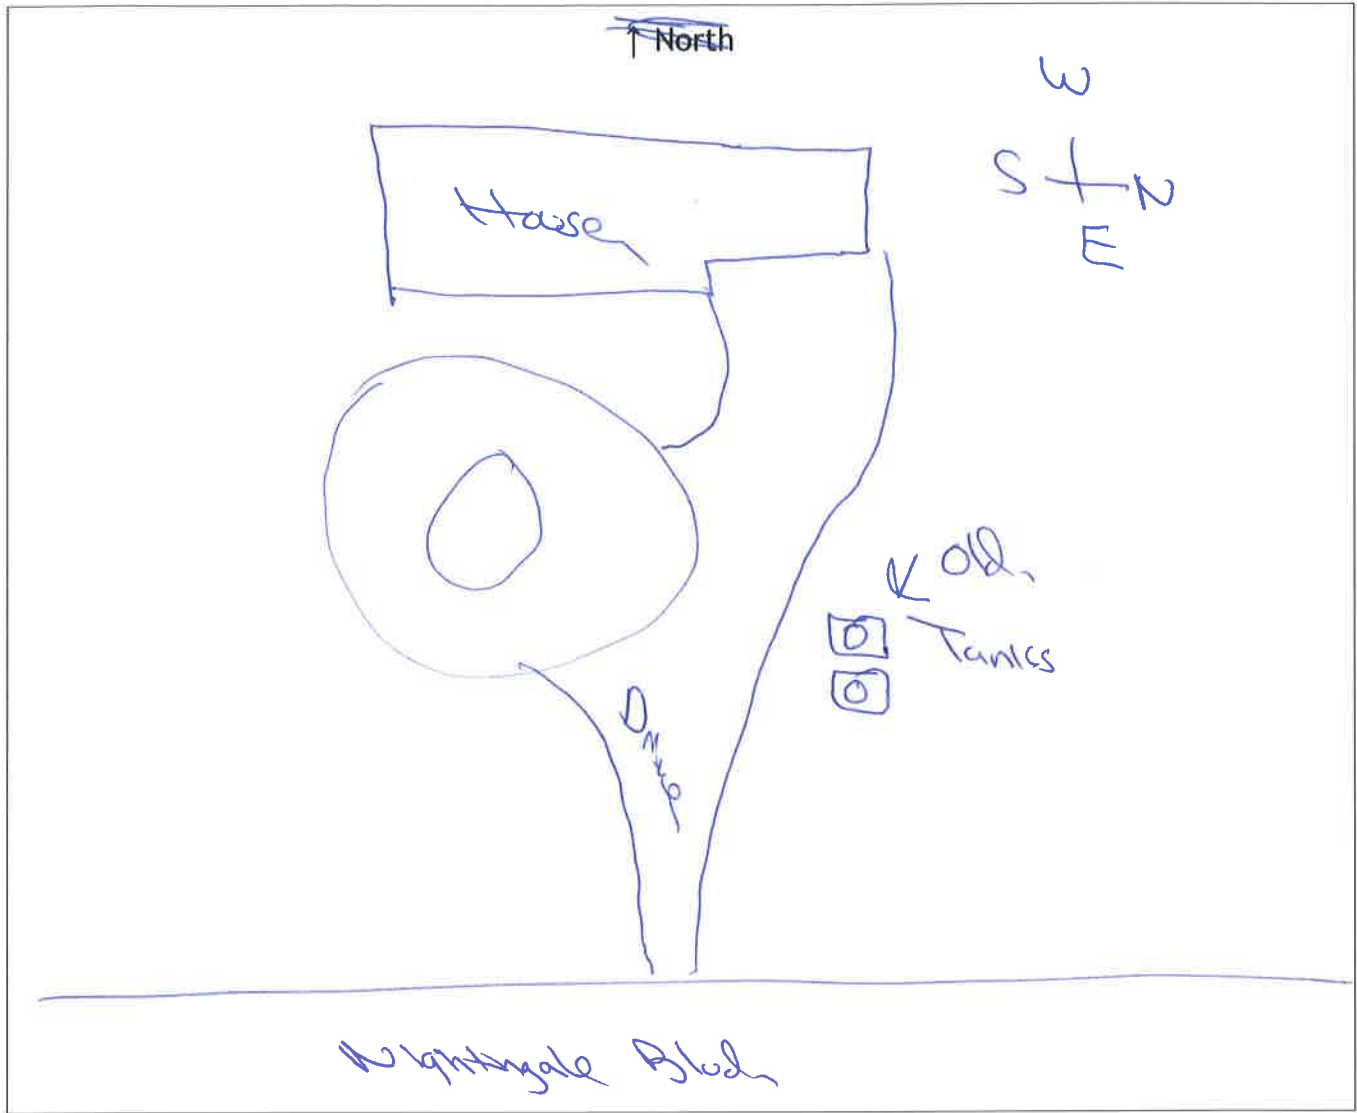

Certification

I hereby certify the system was abandoned in accordance with Minn. R. 7080.2500 and any local requirements.

Name (please print): Rick Fehr Title: Owner

Address: 12539 Manning Tr. N

City: Hugo State: MN Zip: 55038

Phone: 651-755-2782 License # if applicable: MPCA # 52

Date: 12-8-2016 Signature: [Signature]