



**Minnesota Pollution Control Agency**  
 520 Lafayette Road North  
 St. Paul, MN 55155-4194

# SSTS Abandonment Reporting Form

## Subsurface Sewage Treatment Systems (SSTS) Program

### Instructions

This form is offered to meet the abandonment requirements of Minn. R. 7080.2500 and Disclosure Requirements of Minn. Stat. § 115.55, subd. 6. Future water supply well placement can also be affected by an abandoned SSTS.

The use of this form is not mandatory; however the information on this form must be submitted to the local government unit (LGU) within 90 days after the abandonment. This form may be completed by a certified SSTS practitioner or by an individual who has direct knowledge of how the system was abandoned.

### Property Information

Date of abandonment: 12-12-2016 Reason for abandonment: Hookup to City Sewer

---

Property owner name(s): Patricia Kennedy

Property owner's address: 1200 Northgate Blvd Stillwater MN

City: Stillwater State: MN Zip: 55082

Site address (if different): Same

City: \_\_\_\_\_ State: \_\_\_\_\_ Zip: \_\_\_\_\_

### Compliance Information

1. All solids and liquids removed from all tanks?  Yes  No  
 Disposal Site: Parkys Sewer

---

2. All electrical devices and devices containing mercury removed?  Yes  No  
 Disposal Site: \_\_\_\_\_

---

3. All underground sewage tanks crushed and filled with soil or rock material?  Yes  No or  
 Removed and disposed off site?  Yes  No  
 Disposal Site: \_\_\_\_\_

---

4. Contaminated materials\* removed and disposed off site?  Yes  No  
 Disposal Site: Parkys Sewer

---

5. All underground cavities\*\* crushed and filled with soil or rock material?  Yes  No or  
 Removed and disposed off site?  Yes  No  
 Disposal Site: \_\_\_\_\_

---


6. Future discharge to system permanently denied?  Yes  No  
 Method(s) used: \_\_\_\_\_

\*Contaminated materials = Distribution media, soil or sand within three feet of the system bottom, distribution pipes, geotextile fabric/rosin paper/straw, tanks, contaminated soil around leaking tanks, any soil that received sewage from a surface failure (7080.2500 subp.3).

\*\*Underground cavities = Cesspools, leaching pits, drywells, seepage pits, vault privies, pit privies, pump chambers (7080.2500 subp. 1). Does not include chamber media, drop boxes, or distribution boxes.

# Map

Include location of building sewer, septic tank(s), soil dispersal system, cesspools, seepage pits, and other pits. Also include a permanent reference point(s) and dimensions.

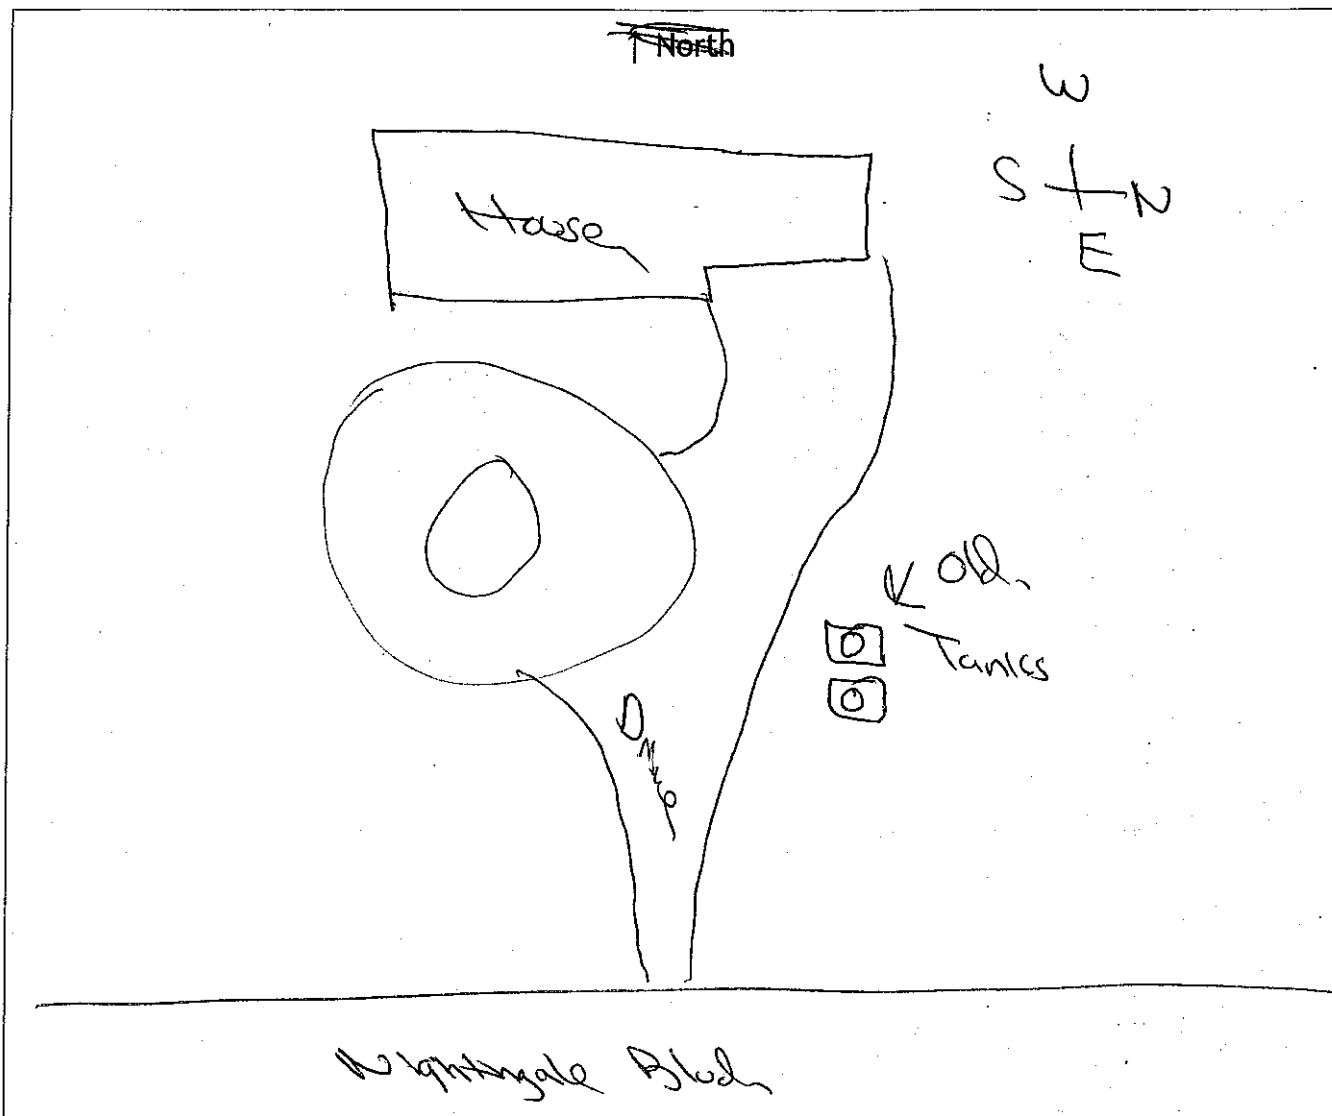

## Certification

I hereby certify the system was abandoned in accordance with Minn. R. 7080.2500 and any local requirements.

Name (please print): Rick Fehr Title: Owner  
Address: 12539 Manning Tr. N  
City: Hugo, State: MN Zip: 55038  
Phone: 651-755-2782 License # if applicable: MPCA # 52  
Date: 12-8-2016 Signature: [Signature]

**B**

\* 2 0 1 6 - 0 1 1 8 5 \*

## City of Stillwater

## Inspections List Report

Actual Date To: 12/16/2016 Permit # From: 2016-01185 To: 2016-01185

Permit Type: All Property Type: All Construction Type: All

Inspector: All Status: Pass/Fail/No Status

Include Notes: Yes

Permit #	Site Address	Applicant						
	Inspection Type	Status	Sched Date	Time	Insp	Actual Date	Insp	
2016-01185	1200 NIGHTINGALE BLVD	FUHR TRENCHING INC						
	SEWER & WATER/PRIVATE SEPTIC	Pass	12/12/2016	11:59 AM	CITY	12/12/2016	JON2	
	*Removed the old tanks & installed one new tank with pump and directional bored 2" pipe, to pump the sewage out to the city manhole in the street.							
	SSTS ABANDONMENT REPORT SUBI	Pass	12/12/2016	08:45 AM	CITY	12/12/2016	JON2	
	Form submitted							