


**Minnesota Pollution
Control Agency**

 520 Lafayette Road North
St. Paul, MN 55155-4194

SSTS Abandonment Reporting Form

Subsurface Sewage Treatment Systems (SSTS) Program

Instructions

This form is offered to meet the abandonment requirements of Minn. R. 7080.2500 and Disclosure Requirements of Minn. Stat. § 115.55, subd. 6. Future water supply well placement can also be affected by an abandoned SSTS.

The use of this form is not mandatory; however the information on this form must be submitted to the local government unit (LGU) within 90 days after the abandonment. This form may be completed by a certified SSTS practitioner or by an individual who has direct knowledge of how the system was abandoned.

Property Information

 Date of abandonment: 04/10/24 Reason for abandonment: Non compliant system

 Property owner name(s): Amherst H. Wilder Foundation

 Property owner's address: 14189 Ostlund Trail N

 City: Marine on the St Croix State: MN Zip: 55047

 Site address (if different): PID# 2203120140001

City: _____ State: _____ Zip: _____

Compliance Information

 1. All solids and liquids removed from all tanks? Yes No
 Disposal Site: Meyers sewer service

 2. All electrical devices and devices containing mercury removed? Yes No
 Disposal Site: N/A

 3. All underground sewage tanks crushed and filled with soil or rock material? Yes No or
 Removed and disposed off site? Yes No
 Disposal Site: N/A

 4. Contaminated materials* removed and disposed off site? Yes No
 Disposal Site: N/A

 5. All underground cavities** crushed and filled with soil or rock material? Yes No or
 Removed and disposed off site? Yes No
 Disposal Site: _____

 6. Future discharge to system permanently denied? Yes No
 Method(s) used: _____

Tank was crushed and filled Out building was hauled away

*Contaminated materials = Distribution media, soil or sand within three feet of the system bottom, distribution pipes, geotextile fabric/rosin paper/straw, tanks, contaminated soil around leaking tanks, any soil that received sewage from a surface failure (7080.2500 subp. 3).

**Underground cavities = Cesspools, leaching pits, drywells, seepage pits, vault privies, pit privies, pump chambers (7080.2500 subp. 1). Does not include chamber media, drop boxes, or distribution boxes.

Map


Include location of building sewer, septic tank(s), soil dispersal system, cesspools, seepage pits, and other pits. Also include a permanent reference point(s) and dimensions.

↑ North

See next
page


Certification

I hereby certify the system was abandoned in accordance with Minn. R. 7080.2500 and any local requirements.


Name (please print): Joseph Handrahan Title: Installer
Address: 2340 Leibel St
City: White Bear Lake State: MN Zip: 55110
Phone: 651-762-2500 License # if applicable): 1510
Date: 04/16/24 Signature: 



~~Structure removed tanks crushed/filled~~ Structure removed tanks crushed/filled

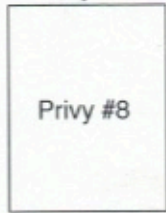

○ ST-1

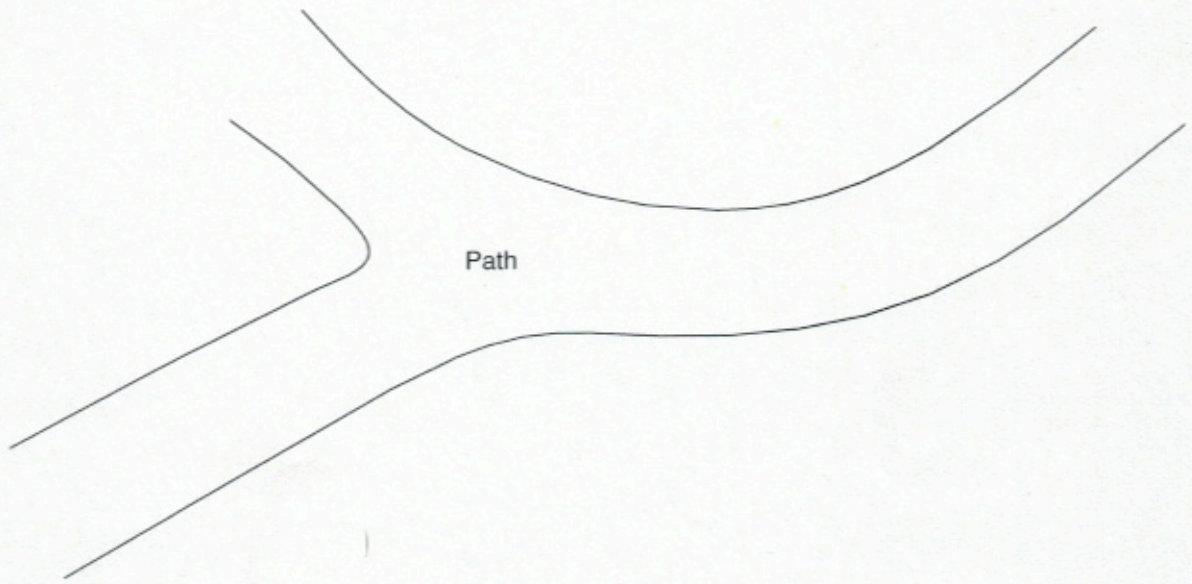

NO SCALE

PID #2203120140001, May Twp, MN 55082 - Privy #8

6000

LOT

2

14189

Campground
Shower

Privy #8

Maintenance Shop

School
House

14189

