


## Map

Include location of building sewer, septic tank(s), soil dispersal system, cesspools, seepage pits, and other pits. Also include a permanent reference point(s) and dimensions.

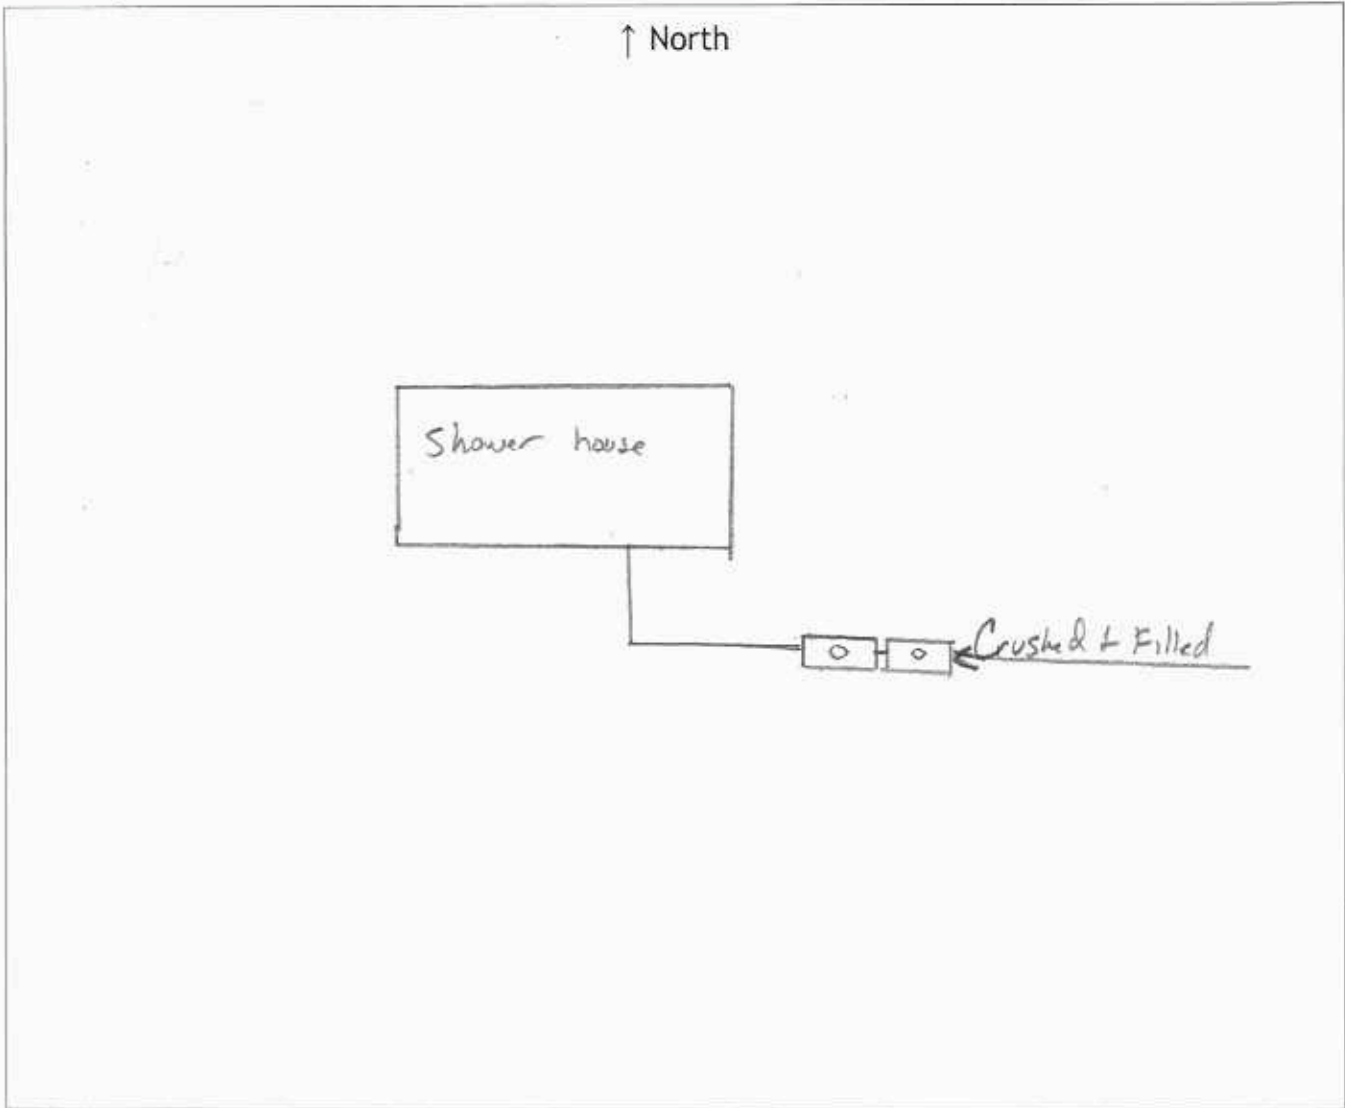

## Certification

I hereby certify the system was abandoned in accordance with Minn. R. 7080.2500 and any local requirements.

Name (please print): John Handrahan Title: Farmer  
Address: 2340 Leibel St  
City: White Bear Lake State: MN Zip: 55160  
Phone: 651-762-2500 License # if applicable: 1510  
Date: 10-8-24 Signature: [Handwritten Signature]