

November 1, 2016
4749 Trading Post Trail So.
Afton, MN 55001

Mr. Pete Ganzel
Senior Environmental Specialist
Department of Public Health and Environment
19955 Forest Road North
Forest Lake, MN 55025

Pete,

Attached per our phone conversations are copies of the documents relating to the design and installation of the septic system for our home at the above address in 1995. My understanding is that for whatever reason these are missing from the Washington County Records. These documents were obtained from the City of Afton and Featherstone Excavating.

The site along with a backup field immediately adjacent to the west of the installation was proven by percolation tests performed by Ed Eklin. With his death in 2010 however, all records including data from those tests were apparently destroyed. This work for approval of the septic system was done prior to our purchase of the land and was a contingency on our purchase of the parcel.

It is my understanding that this documentation should clear up any issues regarding the compliance of our system with regulations and satisfy the needs outlined in the correspondence dated May 24, 2016 from Girard Goder and received by me October 14, 2016, a copy of which is also attached.

Sincerely,

A handwritten signature in black ink, appearing to be 'Andrew Fraser', written over a horizontal line.

Andrew Fraser

BCB



WASHINGTON COUNTY, MINNESOTA
Department of Health, Environment & Land Management

INSPECTION REQUEST DETAIL

DATE 9/07/95

Requested Date 9/07/95 Requested Time 3:00 Priority 92

Application Number 1 95015

Owner Name ANDY FRASER

Project Address 0 TRADING POST TR S
Municipality AFTON CITY

Inspection Type SEPTIC For FEATHERSTONE EXCAVATING

Special Instructions LARGE SYSTEM

Inspector P. Cozzel Date 9-7-95 Time _____

Corrections _____

Ok to Close

Signature _____

AS-BUILT REPORT INDIVIDUAL SEWAGE TREATMENT SYSTEM

Washington County Health, Environment & Land Management
 14900 61ST ST N, PO BOX 3803, STILLWATER, MN 55082-3803
 612/430-6708 or 612/430-6656 FAX 612/430-6730

Legal Description or Complete Street Address		City or Township		
4749 Tradeg Post tr. S.		Attn Mn 55001		
Owner Name	Mail Address	City	State	Zip
Andy Fraser				
Installer	Mail Address	City	State	Zip
Feathusba Eric	368 Taw Rd	Hudson Wis		54016
Septic Tank Information	Tank Manufacturer:	Liquid Capacity:		
	Al Concrete	1500 ± 1000		

PUMP CHAMBER (if installed)			
Tank Manufacturer:	Liquid Capacity:	Horsepower of Pump:	Type of Warning Device:
Pump Discharge in Gallons Per Minute: Head	at	Feet of	Number of Gallons Pumped Per Cycle:

DRAINFIELD TRENCH		BED OR MOUND		
Width: 36"	Length of Each Trench: 3 @ 45' ± 3 @ 60'	Rock Bed Length:	Width:	Area:
Depth of Trench Bottom from Finished Grade: 24"		Bed Depth from Grade:		
Method of Distribution: <input type="checkbox"/> Pressure <input type="checkbox"/> Distribution Box <input checked="" type="checkbox"/> Drop Box		MOUND: Upslope Sand Base Depth: Downslope Sand Base Depth:		
Depth of Rock Under Distribution Pipe: 12		Depth of Rock Under Pipe:		
Square Footage of Tested Area Used: 950		PRESSURE DISTRIBUTION SYSTEM:		
Trench Bottom Square Footage Required: 950	Area As Built: 950	Lateral Inside Diameter:	Length:	Perforation Size:
		Spacing:	Number:	Perforation Spacing:

Complete site plan on attached sheet. On the site plan, include location of:
 structures, septic tank, pump chamber, line from house to tank treatment system, distribution lines, distribution or drop boxes, well, and driveway. Show all distances applicable to the sewage treatment system (distance from structure to tank, tank to treatment system, distance between distribution lines, length of distribution lines, and distance between well and sewage treatment system). Indicate NORTH on the site plan and the scale of the plan.

ASBUILT.FRM:DC 9

WASHINGTON COUNTY SEPTIC PERMIT NUMBER 019 5015

AN EQUAL EMPLOYMENT OPPORTUNITY/AFFIRMATIVE ACTION EMPLOYER


IF YOU NEED ASSISTANCE DUE TO DISABILITY OR LANGUAGE BARRIER, PLEASE CALL 430-6708 (TDD 439-3220).

FRASER RESIDENCE


S 1°02'27" E 767.16

604.10

163.08

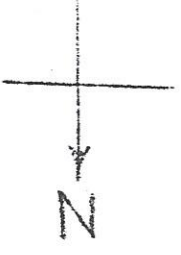

SCALE: 1" = 10'

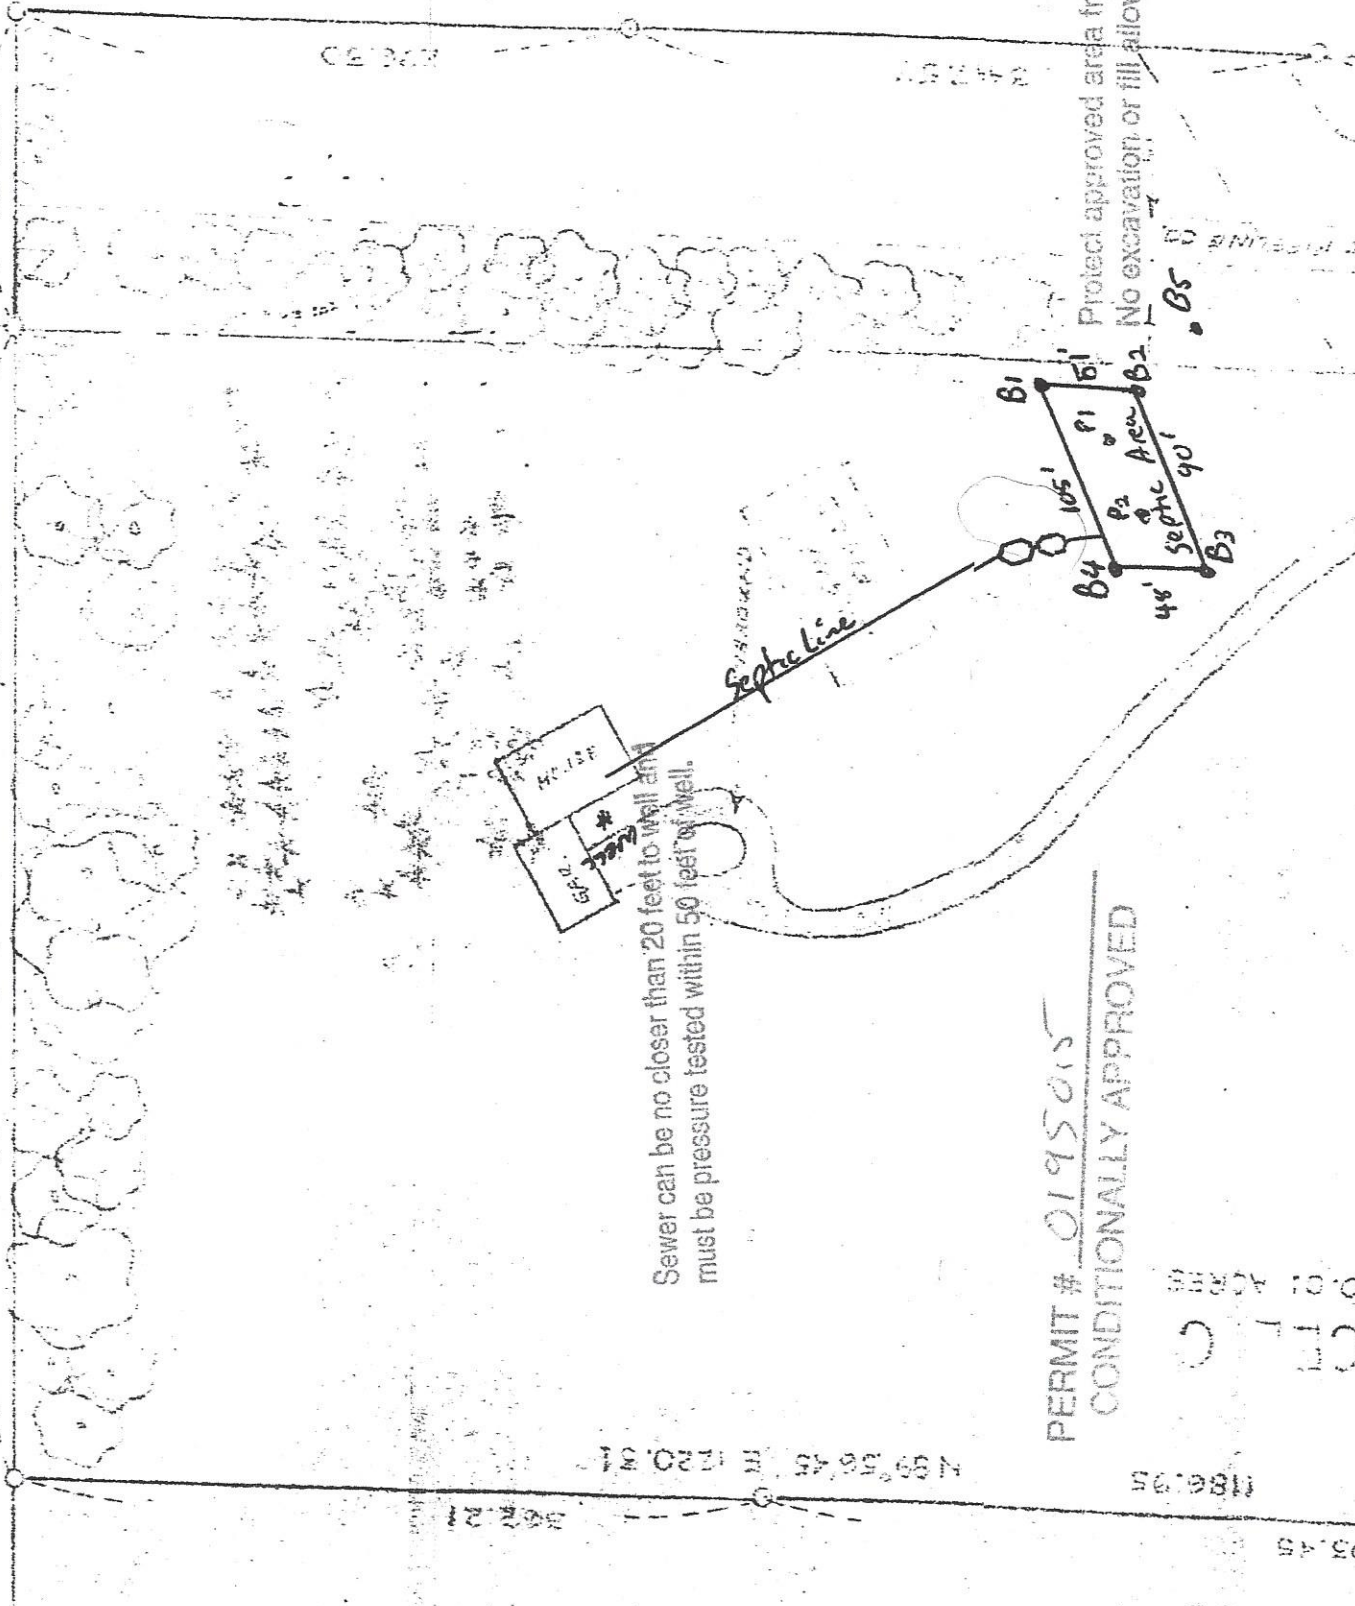

Sewer can be no closer than 20 feet to well and must be pressure tested within 50 feet of well.

Protected area from traffic. No excavation or fill allowed in this area.

PERMIT # 0195015
CONDITIONALLY APPROVED

1186195
193.49



N 89°38'43" E 1220.31

1186195

PERMIT # 0195015
CONDITIONALLY APPROVED

PARCEL C
20.01 ACRES

Protect approved area from traffic.
No excavation or fill allowed in this area.

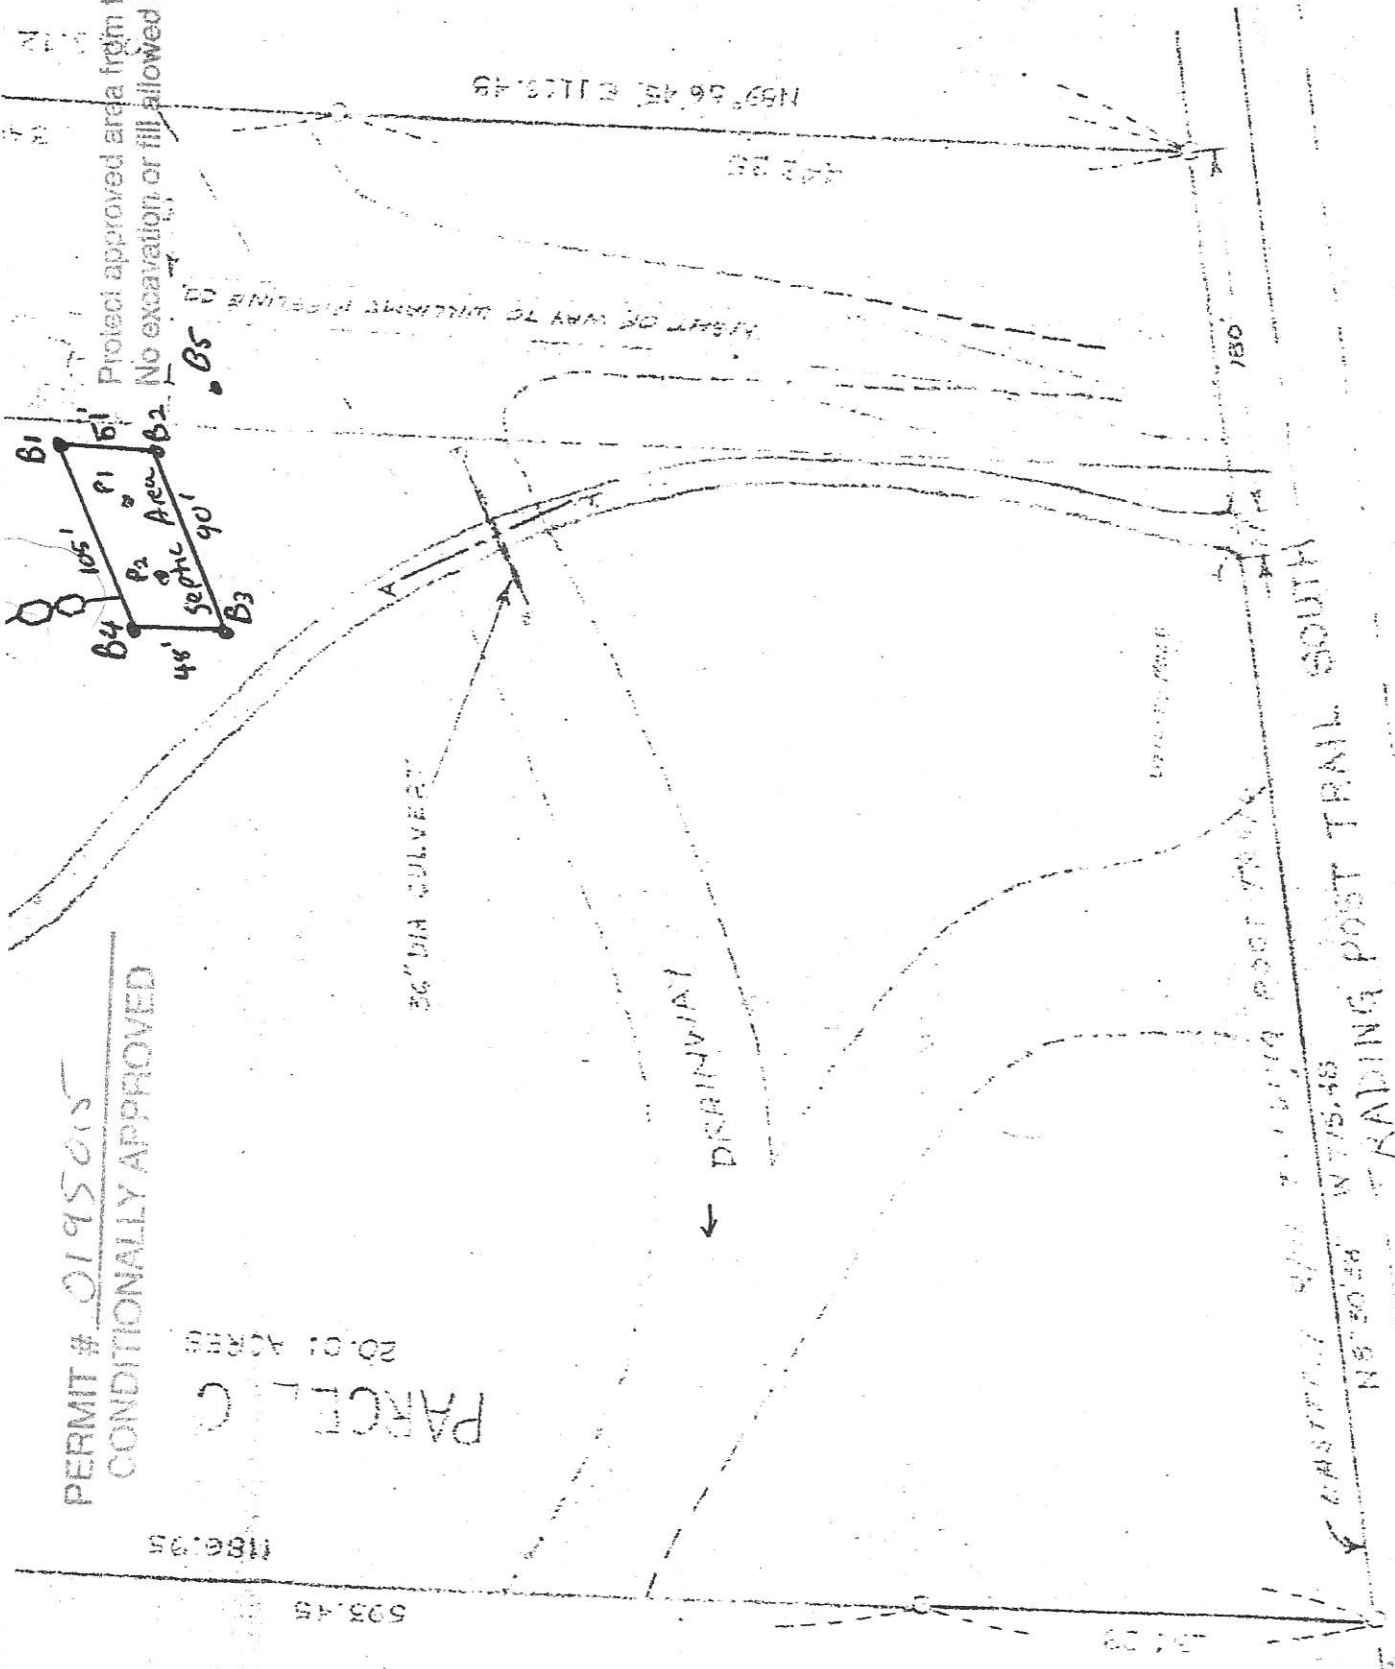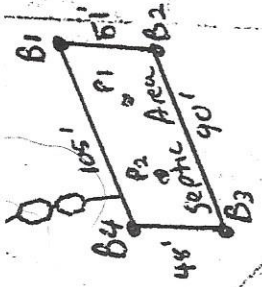

36" DIA CULVERT


→ DRIVINWAY

TRADING POST TRAIL SOUTH

Andy Fraser
4749 Trading post Tr S
Afton mn 55001

$\frac{1}{4}'' = 10'$

← NORTH

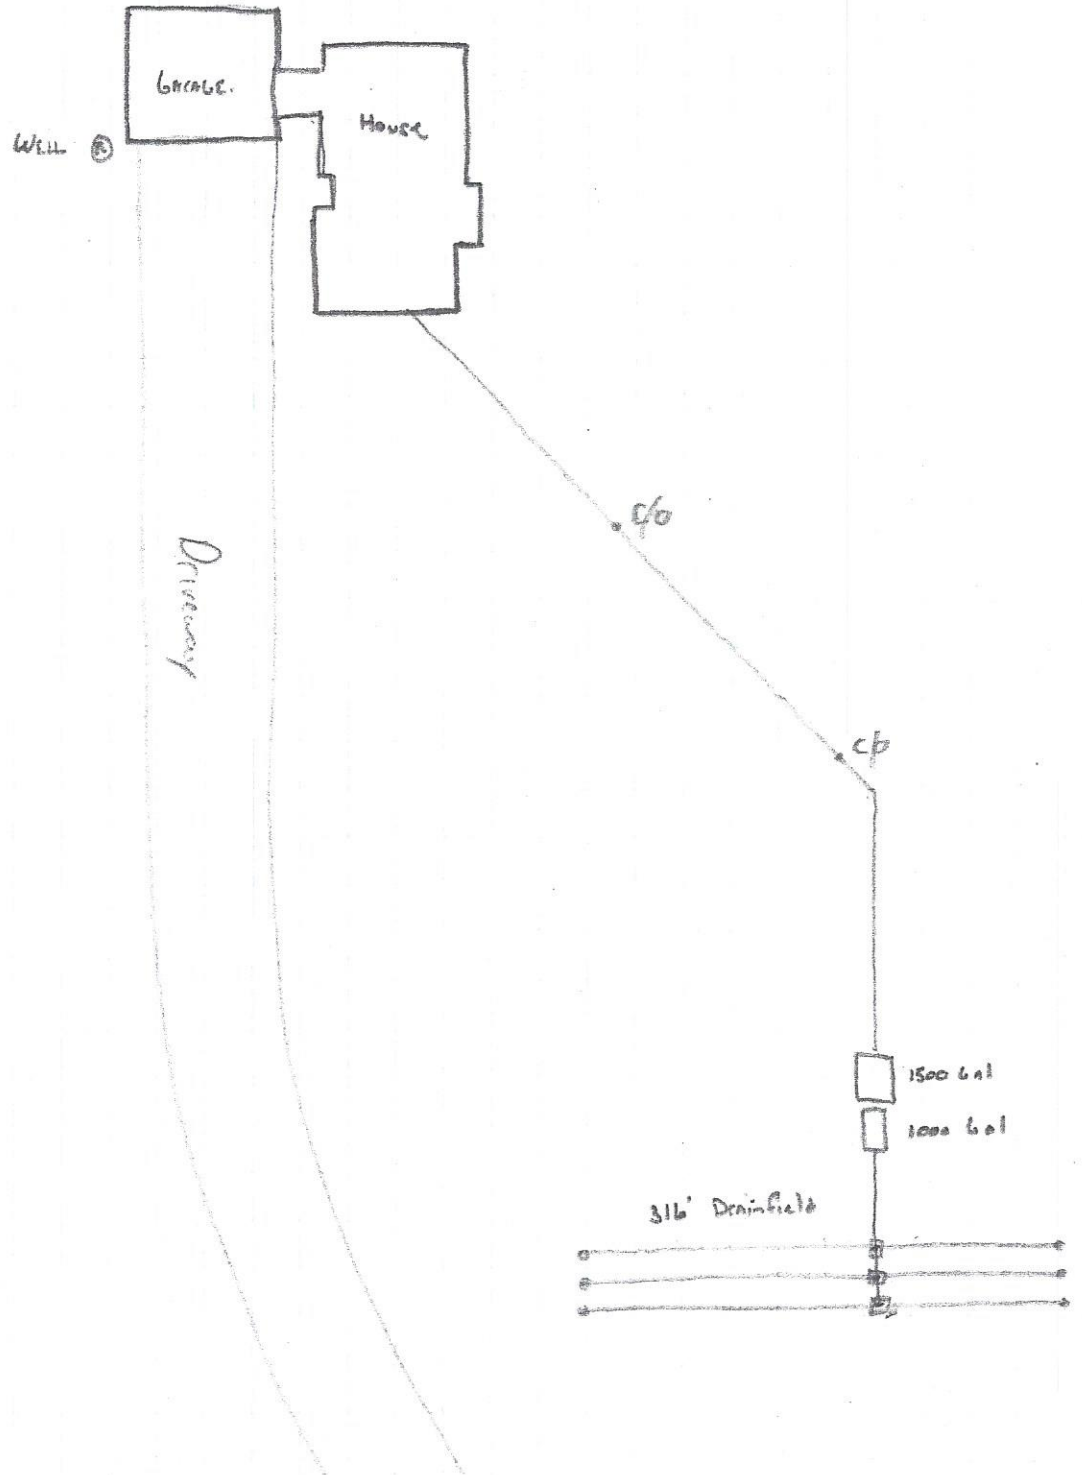

WASHINGTON COUNTY, MINNESOTA
Department of Health, Environment,
and Land Management 612/430-6708
AFTON CITY

PERMIT NUMBER 0195015 SEWAGE PERMIT

Owner : ANDY FRASER
8 AFTON COULEE RIDGE
AFTON MN 55001
Applicant : ANDY FRASER 612-436-6511

SEPTIC APPLICATION	100.00
SEPTIC SYSTEM PERMIT	100.00
Total Fees :	200.00
Total Paid :	100.00
Total Due :	100.00

PERMISSION IS HEREBY GRANTED

To execute the work specified in this permit on the following described property upon express condition that said persons and their agents, employees and workmen shall conform in all respects to the provisions of the Building Code, and/or Ordinances.
This permit may be revoked at any time upon the violation of any of the provisions of said code and ordinances.

Project Address : TRADING POST TR S AFTON MN 55001

Flow Capacity 750 Gal/Day

Soil Conditions: Depth to Restriction 60 Inches Perc Rate 14 Min/Inch

Soil Treatment Area Type:

In Ground Y In Fill N Bed N Drain Field Y

Authorized Work / Special Conditions

- Install individual sewage treatment system as per approved design in area tested and shown on site plan.
- THIS SYSTEM MUST BE INSTALLED BY A CERTIFIED/LICENSED SEWAGE TREATMENT SYSTEM INSTALLER HOLDING A CURRENT LICENSE WITH WASHINGTON COUNTY. (A list of licensed installers is available at your request.)

** Permit Expiration Date : Sewage Treatment : 6/03/96

A CERTIFICATE OF OCCUPANCY MUST BE REQUESTED AND ISSUED PRIOR TO USE OR OCCUPANCY OF WORK PERMITTED BY A BUILDING PERMIT.

** This permit shall expire and be null and void if the work authorized by the Building Permit is not commenced within 60 days of the date of issuance or if work is abandoned or suspended for a period of 120 days. Term of the Building Permit is 12 months from date of issue. Term of sewage treatment permit is 6 months from date of issue.

Penalty for violation of any of the provisions of building code: Fine not to exceed five hundred dollars (\$500.00) or imprisonment for not more than ninety (90) days, or both.

Permit Issue Date 6/03/95 Code Enforcement Officer 