

\* Hart 1981 1991 1994 1994

## **Compliance Inspection Form**

## **Existing Subsurface Sewage Treatment Systems (SSTS)**

Doc Type: Compliance and Enforcement

	nesota Pollution Control Agency (MPCA) additional local requirements may also apply.	For local tracking purposes:				
Submit completed form to Local within 15 days	Unit of Government (LUG) and system own	ner				
System Status						
System status on date (mn	n/dd/yyyy):06/21/2017					
	date, unless shorter time (See Up	ompliant – Notice of Noncompliance grade Requirements on page 3.)				
Reason(s) for noncompliance (check all applicable)  Impact on Public Health (Compliance Component #1) – Imminent threat to public health and safety  Other Compliance Conditions (Compliance Component #3) – Imminent threat to public health and safety  Tank Integrity (Compliance Component #2) – Failing to protect groundwater  Other Compliance Conditions (Compliance Component #3) – Failing to protect groundwater  Soil Separation (Compliance Component #4) – Failing to protect groundwater  Operating permit/monitoring plan requirements (Compliance Component #5) – Noncompliant						
Property Information	Parcel ID# or Sec/Tw	b/Range: 33.032.20.31.0020				
		o/Range: 33.032.20.31.0020 ason for inspection: property sale				
Property address: 12636 182 <sup>nd</sup> S Property owner: Karen Mergene	St N Marine on St Croix, MN 55047 Re	100 March 100 Ma				
Property address: 12636 182 <sup>nd</sup> S Property owner: Karen Mergene or	St N Marine on St Croix, MN 55047 Re	ason for inspection:property sale ner's phone:651-433-2463				
Property address: 12636 182 <sup>nd</sup> S Property owner: Karen Mergene or Owner's representative:	St N Marine on St Croix, MN 55047 Re Ow	ason for inspection: _property sale				
Property address: 12636 182 <sup>nd</sup> S Property owner: Karen Mergene or Owner's representative: Local regulatory authority: Was 1200	Ref N Marine on St Croix, MN 55047  Ref Ow  Ref Refington County  Regallon septic tank & 1000 gallon pump tank lift	ason for inspection: _property sale ner's phone: _651-433-2463 presentative phone:				
Property address: 12636 182 <sup>nd</sup> S Property owner: Karen Mergene or Owner's representative: Local regulatory authority: Was 1200 Brief system description: on the	Ref N Marine on St Croix, MN 55047 Refer Own Rehington County Regallon septic tank & 1000 gallon pump tank lifter high area on the south side of 182 <sup>nd</sup> St.	ason for inspection: _property sale ner's phone: _651-433-2463  presentative phone:				
Property address: 12636 182 <sup>nd</sup> S Property owner: Karen Mergene or Owner's representative: Local regulatory authority: Was 1200 Brief system description: on the	Remark Marine on St Croix, MN 55047  Remark Marine Ma	ason for inspection: _property sale ner's phone: _651-433-2463  presentative phone:				
Property address: 12636 182 <sup>nd</sup> S Property owner: Karen Mergene or Owner's representative: Local regulatory authority: Was 1200 Brief system description: on the	Remark Marine on St Croix, MN 55047  Remark Marine Ma	presentative phone:				
Property address:	Remark Marine on St Croix, MN 55047  Remark Marine Mari	presentative phone:				
Property address:	Re hington County Re gallon septic tank & 1000 gallon pump tank lift high area on the south side of 182 <sup>nd</sup> St.  Seaking and taking in ground water. Peterson Expanding the programment of the programment	ason for inspection:property sale ner's phone:651-433-2463  presentative phone: gulatory authority phone:651-430-6655  ing to 380 SF rock trench, gravity drainfield located  accavating pumped the tank and repaired the leak.  the the compliance status of this system. No				
Property address:12636 182 <sup>nd</sup> S Property owner:Karen Mergene or Owner's representative: Local regulatory authority:Was	Remark Marine on St Croix, MN 55047  Remark Mari	ason for inspection:property sale ner's phone:651-433-2463  presentative phone: gulatory authority phone:651-430-6655  ing to 380 SF rock trench, gravity drainfield located  accavating pumped the tank and repaired the leak.  the the compliance status of this system. No inknown conditions during system construction,				


Nec	essary or Locally	Required A	Attachments			
$\boxtimes$	☑ Soil boring logs ☑ System/As-built drawing		As-built drawing	☐ Forms per local ordinance		
	Other information (list):		\$ 100 miles   100			
Property address: 12636 182nd St N Marine on St Croix, MN 55047			ne on St Croix, MN 55047	Inspector initials/Date: TT   6/21/2017 (mm/dd/yyyy)		
1.	Impact on Public	<b>Health</b> – C	ompliance componer	nt #1 of 5		
	Impact on Public Health – Compliance compone					
	Compliance criteria:			Verification method(s):		
	System discharges sewa ground surface.	age to the	☐ Yes ☒ No	Searched for surface outlet		
	System discharges sewa	age to drain	☐ Yes ☒ No	Searched for seeping in yard/backup in home		
	tile or surface waters.	ago to didili	Li les Millo	<ul> <li>☑ Excessive ponding in soil system/D-boxes</li> <li>☑ Homeowner testimony (See Comments/Explanation)</li> </ul>		
	System causes sewage		☐ Yes ☒ No	"Black soil" above soil dispersal system		
	dwelling or establishmer	nt.		☐ System requires "emergency" pumping ☐ Performed dye test		
	Any "yes" answer	above indi	cates the			
	system is an immi	nent threat	to public	☐ Unable to verify (See Comments/Explanation)		
	health and safety.			☐ Other methods not listed (See Comments/Explanation)		
	Comments/Explanation	n:		a street method not noted (see comments/Explanation)		
2	Tank Integrity – C	ompliance (	companent #2 of F			
		ompliance (	component #2 of 5			
	Compliance criteria:			Verification method(s):		
	System consists of a see cesspool, drywell, or lead	epage pit,	☐ Yes ☒ No	☑ Probed tank(s) bottom		
				☐ Examined construction records		
	Seepage pits meeting 7080 compliant if allowed in local	ordinance.		Examined Tank Integrity Form (Attach)		
	Sewage tank(s) leak belo		☐ Yes ☒ No	Observed liquid level below operating depth		
	designed operating dept			☐ Examined empty (pumped) tanks(s)		
	If yes, which sewage tan			Probed outside tank(s) for "black soil"		
	Any "yes" answer above indicates the system is failing to protect groundwater.			☐ Unable to verify (See Comments/Explanation)		
				☐ Other methods not listed (See Comments/Explanation)		
	Comments/Explanation	n:				
	•					
3.	Other Compliance	Condition	s – Compliance compor	nent #3 of 5		
	b. Other issues (electrical hazards, etc.) to immediately and adversely impact public health or safety.					
		nent threat to	public health and safety.			
	Explain:		(A)			
	c. System is non-protective of ground water for other conditions as determined by inspector . ☐ Yes* ☐ No *System is failing to protect groundwater.					

Explain:

Property address: 12636 182nd St N Marine of	on St Croix, MN 55047	Inspector initials/Date:	TT   6/21/2017				
			(mm/dd/yyyy)				
4. Soil Separation - Compliance component #4 of 5							
1973 septic tank. Drainfield was		Verification method(s):					
disconnected & pump tank & new drainfield in 1989 (mm/dd/yyyy)	☑ Unknown	Soil observation does not expire. Previous soil observations by two independent parties are sufficient, unless site conditions have been altered or local requirements differ.					
Shoreland/Wellhead protection/Food beverage lodging?	⊠ Yes □ No	Conducted soil observation(s) (Attach boring logs)					
Compliance criteria:		☐ Two previous verifications (Attach boring logs)					
For systems built prior to April 1, 1996, and	☐ Yes ☐ No	☐ Not applicable (Holding tank(s), no drainfield)					
not located in Shoreland or Wellhead	L res Lino	☐ Unable to verify (See Comments/Explanation)					
Protection Area or not serving a food, beverage or lodging establishment:		☐ Other (See Comments/Explanation)					
Drainfield has at least a two-foot vertical separation distance from periodically saturated soil or bedrock.							
Non-performance systems built April 1,	⊠ Yes □ No	Comments/Explanation:					
1996, or later or for non-performance systems located in Shoreland or Wellhead		0-6t med/fine sand					
Protection Areas or serving a food, beverage, or lodging establishment:			6-35 loamy sand				
Drainfield has a three-foot vertical		35-64 sand7.5 YR 5/4					
separation distance from periodically saturated soil or bedrock.*		64-76 fine sand	10 YR 4/6				
"Experimental", "Other", or "Performance"	☐ Yes ☐ No	Indicate depths or elevations					
systems built under pre-2008 Rules; Type IV or V systems built under 2008 Rules (7080.		A. Bottom of distribution media	24-36				
2350 or 7080.2400 (Advanced Inspector License required)		B. Periodically saturated soil/bedrock					
Drainfield meets the designed vertical		C. System separation	40				
separation distance from periodically saturated soil or bedrock.							
Any "no" answer above indicates ti	he system is	D. Required compliance separation*  *May be reduced up to 15 percent if	36 allowed by Local				
failing to protect groundwater.	io dydiam io	Ordinance.					
5. Operating Permit and Nitrogen	BMP* - Compliand	ce component #5 of 5	ot applicable				
Is the system operated under an Operating		⊠ No If "yes", A below is require	CONTRACTOR OF THE PROPERTY OF				
Is the system required to employ a Nitroger		⊠ No If "yes", B below is require					
BMP = Best Management Practice(s) specified in the system design							
If the answer to both questions is "no", this section does not need to be completed.							
Compliance criteria		,					
a. Operating Permit number: n/a							
Have the Operating Permit requireme	nts been met?	☐ Yes ☐ No					
b. Is the required nitrogen BMP in place		g?					
		110					

www.pca.state.mn.us • 651-296-6300 • 800-657-3864 • TTY 651-282-5332 or 800-657-3864 • Available in alternative formats wq-wwists4-31b • 6/4/14

Upgrade Requirements (Minn. Stat. § 115.55) An imminent threat to public health and safety (ITPHS) must be upgraded, replaced, or its use discontinued within ten months of receipt of this notice or within a shorter period if required by local ordinance. If the system is failing to protect ground water, the system must be upgraded, replaced, or its use discontinued within the time required by local ordinance. If an existing system is not failing as defined in law, and has at least two feet of design soil separation, then the system need not be upgraded, repaired, replaced, or its use discontinued, notwithstanding any local ordinance that is more strict. This provision does not apply to systems in shoreland areas,

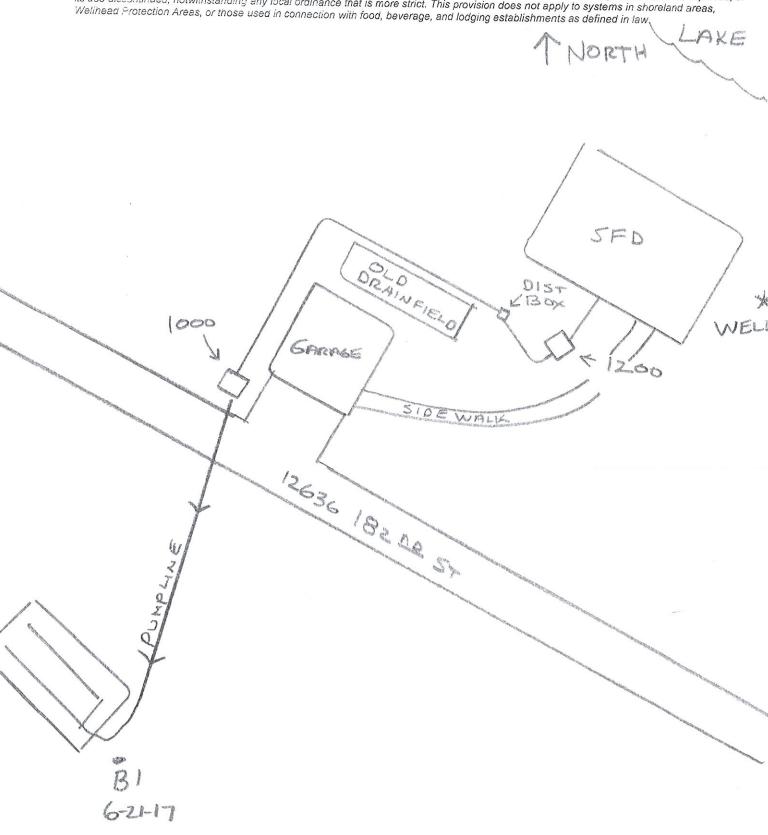

www.pca.state.mn.us ... 651-296-6300 800-657-3864 TTY 651-282-5332 or 800-657-3864 Available in alternative formats