

520 Lafayette Road North St. Paul, MN 55155-4194

Compliance Inspection Form

Existing Subsurface Sewage Treatment Systems (SSTS)

Doc Type: Compliance and Enforcement

		_		
Inspection results based requirements and attached f	d on Minnesota Pollution Control Agency (forms – additional local requirements may	(MPCA) v also apply.	For local tracking purposes:	
Submit completed form to within 15 days	ว Local Unit of Government (LUG) and	system owner		
System Status				
System status on da	ite (mm/dd/yyyy): 8/1/2017			
○ Compliant – Ce (Valid for 3 years from frame outlined in Local	rtificate of Compliance report date, unless shorter time al Ordinance.)	Noncomplia (See Upgrade R	ant – Notice of Noncompliance Requirements on page 3.)	
Reason(s) for none	compliance (check all applicable)			
	(Compliance Component #1) – Imminen	t threat to public hea	Ith and safety	
☐ Other Complian	ce Conditions (Compliance Component	#3) – Imminent threa	it to public health and safety	
☐ Tank Integrity (Compliance Component #2) – Failing to p	protect groundwater		
Other Complian	ce Conditions (Compliance Component	#3) – Failing to prote	ct groundwater	
☐ Soil Separation	(Compliance Component #4) - Failing to	protect groundwate	r	
☐ Operating perm	it/monitoring plan requirements (Complia	ance Component #5)	Noncompliant	
Property Information	-			
	1 41001 127		32.027.21.11.0010	
Property address: 7873 113 th St S Cottage Grove, MN 55016			Reason for inspection:property sale	
Property owner: Florence Patricia Schrantz or		Owner's pho	one: <u>651-459-3696</u>	
Owner's representative:		Representa	tivo phono:	
Local regulatory authority:	Washington County			
Brief system description:	2 1000 gallon septic tanks & 1080 SF of		Regulatory authority phone: 651-430-6655	
Comments or recommenda		or chamber drainileid		
Certification				
determination of future system	ecessary information has been gathered m performance has been nor can be ma n, inadequate maintenance, or future wat	de due to unknown c	npliance status of this system. No conditions during system construction,	
Inspector name: _Tom Troc		000 0000	number: 323	
Business name: All State S	Septic Services LLC	Services a projective respective to the description	number: 1568	
Inspector signature:	700 Inc		number: 612-594-4496	
M				
V-0	Required Attachments			
Soil boring logs	System/As-built drawing	☐ Forms per loc	al ordinance	

	Other information (list):								
Pro	perty address: 7873 113th St S Cottage	e Grove, MN 55016	Inspector initials/Date: TT 8/1/2017 (mm/dd/yyyy)						
1.	Impact on Public Health - C	Compliance compor	nent #1 of 5						
	Compliance criteria:		Verification method(s):						
	System discharges sewage to the	☐ Yes ☒ No	Searched for surface outlet						
	ground surface.		Searched for seeping in yard/backup in home						
	System discharges sewage to drain tile or surface waters.	☐ Yes ☒ No	Excessive ponding in soil system/D-boxes						
	System causes sewage backup into dwelling or establishment.	☐ Yes ☒ No	☐ Homeowner testimony (See Comments/Explanation) ☐ "Black soil" above soil dispersal system						
	Any "yes" answer above indicates the		System requires "emergency" pumping						
	system is an imminent threat		 □ Performed dye test □ Unable to verify (See Comments/Explanation) □ Other methods not listed (See Comments/Explanation) 						
	health and safety.	<u> </u>							
	Comments/Explanation:								
2.	Tank Integrity - Compliance	component #2 of 5	7						
	Compliance criteria:		Verification method(s):						
	System consists of a seepage pit,	☐ Yes ☒ No	☑ Probed tank(s) bottom						
	cesspool, drywell, or leaching pit.								
	Seepage pits meeting 7080.2550 may be compliant if allowed in local ordinance.		☐ Examined Tank Integrity Form (Attach)						
	Sewage tank(s) leak below their	☐ Yes ☒ No	Observed liquid level below operating depth						
	designed operating depth.		☐ Examined empty (pumped) tanks(s)						
	If yes, which sewage tank(s) leaks:		Probed outside tank(s) for "black soil"						
	Any "yes" answer above indi		 ☐ Unable to verify (See Comments/Explanation) ☐ Other methods not listed (See Comments/Explanation) 						
9	System is running to protect groundwater.								
	Comments/Explanation:								
3.	Other Compliance Condition	ns – Compliance com	ponent #3 of 5						
	1075 TW 81		ed, or appear to be structurally unsound. ☐ Yes* ☒ No ☐ Unknown						
	b. Other issues (electrical hazards, etc.) to immediately and adversely impact public health or safety. ☐ Yes* ☒ No ☐ Unknow *System is an imminent threat to public health and safety.								
	Explain:		- 						
	moprissi.								
	c. System is non-protective of ground *System is failing to protect ground		ns as determined by inspector . ☐ Yes* ☑ No						


Explain:

Property address: 7873 113th St S Cottage Gr	ove, MN 55016	Inspector initials/Date:	8/1/2017 (mm/dd/yyyy)		
4. Soil Separation - Compliance co	omponent #4 of 5				
Date of installation: 5/24/2002	Unknown	Verification method(s):			
(mm/dd/yyyy) Shoreland/Wellhead protection/Food beverage lodging? Compliance criteria:	⊠ Yes □ No	Soil observation does not expire. Probservations by two independent particles site conditions have been alto requirements differ.	arties are sufficient,		
For systems built prior to April 1, 1996, and	☐ Yes ☐ No	Conducted soil observation(s) (A	ttach boring logs)		
not located in Shoreland or Wellhead	_ 100 _ 100	☐ Two previous verifications (Attach boring logs)			
Protection Area or not serving a food, beverage or lodging establishment:		☐ Not applicable (Holding tank(s), no drainfield)			
Drainfield has at least a two-foot vertical		☐ Unable to verify (See Comments/Explanation)			
separation distance from periodically saturated soil or bedrock.		Other (See Comments/Explanation)			
Non-performance systems built April 1,	⊠ Yes □ No	Comments/Explanation:	Comments/Explanation:		
1996, or later or for non-performance systems located in Shoreland or Wellhead		0-13 topsoil10 YR 4/3			
Protection Areas or serving a food,		13-47 sand	13-47 sand7,5 YR 5/4		
beverage, or lodging establishment:		47-78 med sand10 YR 4/6			
Drainfield has a three-foot vertical separation distance from periodically saturated soil or bedrock.*					
"Experimental", "Other", or "Performance" systems built under pre-2008 Rules; Type IV	⊡ Yes □ No	Indicate depths or elevations A Bottom of distribution media 36			
or V systems built under 2008 Rules (7080. 2350 or 7080.2400 (Advanced Inspector License required)		A. Bottom of distribution media B. Periodically saturated soil/bedrock	30		
Drainfield meets the designed vertical		C. System separation	42		
separation distance from periodically saturated soil or bedrock.		D. Required compliance separation*	36		
Any "no" answer above indicates t failing to protect groundwater.	he system is	*May be reduced up to 15 percent if allowed by Local Ordinance.			
5. Operating Permit and Nitroger	BMP* – Compli	ance component #5 of 5	Not applicable		
Is the system operated under an Operating	Permit?	res 🗵 No 🏻 If "yes", A below is requi	ired		
Is the system required to employ a Nitroge	n BMP? □ Y	☑ No If "yes", B below is required			
BMP = Best Management Practice(s)	specified in the syste	em design			
If the answer to both questions is "l	no", this section o	does not need to be completed.			
Compliance criteria					
a. Operating Permit number: _n/a	. Operating Permit number:n/a				
Have the Operating Permit requirement	ents been met?	Yes No			
b. Is the required nitrogen BMP in place		oning?			

www.pca.state.mn.us • 651-296-6300 • 800-657-3864 • TTY 651-282-5332 or 800-657-3864 • Available in alternative formats war-wwists4-31b • 6/4/14

Any "no" answer indicates Noncompliance.

Upgrade Requirements (Minn. Stat. § 115.55) An imminent threat to public health and safety (ITPHS) must be upgraded, replaced, or its use discontinued within ten months of receipt of this notice or within a shorter period if required by local ordinance. If the system is failing to protect ground water, the system must be upgraded, replaced, or its use discontinued within the time required by local ordinance. If an existing system is not failing as defined in law, and has at least two feet of design soil separation, then the system need not be upgraded, replaced, or its use discontinued, notwithstanding any local ordinance that is more strict. This provision does not apply to systems in shoreland areas, Wellhead Protection Areas, or those used in connection with food, beverage, and lodging establishments as defined in law.

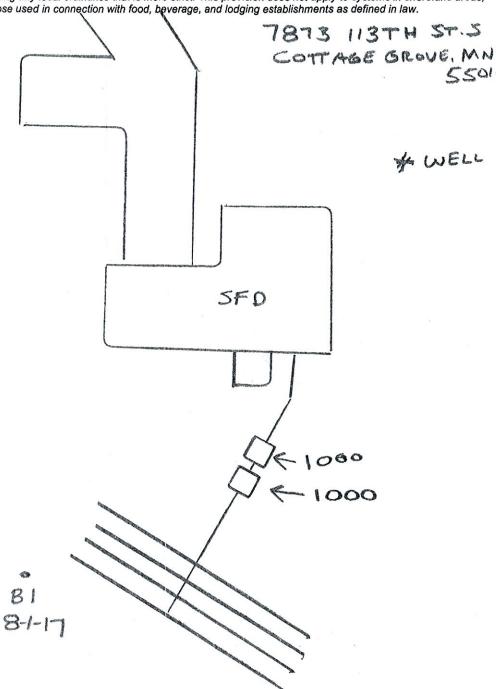

651-296-6300