

520 Lafayette Road North St. Paul, MN 55155-4194

Compliance Inspection Form

Existing Subsurface Sewage Treatment Systems (SSTS)

Doc Type: Compliance and Enforcement

Inspection results based on Minnesota Pollution Control Agency (MPCA) requirements and attached forms – additional local requirements may also apply.	For local tracking purposes:
Submit completed form to Local Unit of Government (LUG) and system ov within 15 days	vner
System Status	
System status on date (mm/dd/yyyy): 4/17/2019	
	compliant – Notice of Noncompliance Opgrade Requirements on page 3.)
Reason(s) for noncompliance (check all applicable)	
☐ Impact on Public Health (Compliance Component #1) – Imminent threat to p	ublic health and safety
☐ Other Compliance Conditions (Compliance Component #3) – Immir	
☑ Tank Integrity (Compliance Component #2) – Failing to protect grou	undwater
☐ Other Compliance Conditions (Compliance Component #3) – Failing	
Soil Separation (Compliance Component #4) – Failing to protect gro	
☐ Operating permit/monitoring plan requirements (Compliance Compe	onent #5) – Noncompliant
Property Information Parcel ID# or Sec/Tw	vp/Range: _31.031.20.14.0004
Property address: 12510 Manning Trl N Hugo, MN 55038 Re	eason for inspection:property sale
Property owner: Fred Schmidt Ov	wner's phone:
or	
Owner's representative: Al Schmidt, Son Re	epresentative phone: 651-257-9004
Local regulatory authority: Washington County Re	egulatory authority phone: 651-430-6655
Brief system description: _Cesspool/drywell system.	
Comments or recommendations:	
Certification	
I hereby certify that all the necessary information has been gathered to determined determination of future system performance has been nor can be made due to a possible abuse of the system, inadequate maintenance, or future water usage.	ne the compliance status of this system. No unknown conditions during system construction,
Inspector name: Tom Trooien Ce	ertification number: 323
Business name: All State Septic Services LLC	License number: 1568
Inspector signature: Tow Troops	Phone number: 612-594-4496
Necessary or Locally Required Attachments	
Other information (list):	
www.pca.state.mn.us • 651-296-6300 • 800-657-3864 • TTY 651-282-5 wq-wwists4-31b • 6/4/14	332 or 800-657-3864 • Available in alternative formats Page 1 of

	ompliance criteria:		Verification method(s):
	stem discharges sewage to the bund surface.	☐ Yes ⊠ No	☑ Searched for surface outlet☑ Searched for seeping in yard/backup in home
	stem discharges sewage to drain e or surface waters.	☐ Yes ☒ No	☐ Excessive ponding in soil system/D-boxes ☐ Homeowner testimony (See Comments/Explanation
	stem causes sewage backup into velling or establishment.	☐ Yes ☒ No	☐ "Black soil" above soil dispersal system
sy	ny "yes" answer above indicates the estem is an imminent threat to public ealth and safety.		 ☐ System requires "emergency" pumping ☐ Performed dye test ☐ Unable to verify (See Comments/Explanation) ☐ Other methods not listed (See Comments/Explanation)
Ta	ınk Integrity – Compliance	component #2 of	5
	empliance criteria:	component #2 or	Verification method(s):
	stem consists of a seepage pit,	⊠ Yes □ No	☑ Probed tank(s) bottom
	sspool, drywell, or leaching pit.		☐ Examined construction records
	epage pits meeting 7080.2550 may be appliant if allowed in local ordinance.		☐ Examined Tank Integrity Form (Attach)
Se	wage tank(s) leak below their signed operating depth.	⊠ Yes □ No	☐ Observed liquid level below operating depth☐ Examined empty (pumped) tanks(s)
If v	es, which sewage tank(s) leaks:		☐ Probed outside tank(s) for "black soil"
ii y	ny "yes" answer above indicates the stem is failing to protect groundwater.		☐ Unable to verify (See Comments/Explanation) ☐ Other methods not listed (See Comments/Explanation)
Ar sy	stem is failing to protect gr		
Ar sy Co	stem is failing to protect gramments/Explanation:	oundwater.	Other methods not listed (See Comments/Explanation)
Ar sy Co	stem is failing to protect gramments/Explanation: her Compliance Condition	oundwater. S – Compliance cor	Other methods not listed (See Comments/Explanation)
Ar sy Co	mments/Explanation: her Compliance Condition Maintenance hole covers are dama	oundwater. S – Compliance conged, cracked, unsecur	☐ Other methods not listed (See Comments/Explanation) mponent #3 of 5 red, or appear to be structurally unsound. ☐ Yes* ☒ No ☐ Unkr
Ar sy Co	her Compliance Condition Maintenance hole covers are dama Other issues (electrical hazards, etc.)	oundwater. S – Compliance conged, cracked, unsecur	☐ Other methods not listed (See Comments/Explanation) mponent #3 of 5 red, or appear to be structurally unsound. ☐ Yes* ☒ No ☐ Unknownsely impact public health or safety. 
Ar sy Co	her Compliance Condition Maintenance hole covers are dama Other issues (electrical hazards, etc.) *System is an imminent threat to	oundwater. S – Compliance conged, cracked, unsecur to immediately and ad public health and sa	☐ Other methods not listed (See Comments/Explanation) mponent #3 of 5 red, or appear to be structurally unsound. ☐ Yes* ☒ No ☐ Unkilitety. Versely impact public health or safety. ☐ Yes* ☒ No ☐ Unkilitety.

Inspector initials/Date: TT | 4/17/2019

Page 2 of 3


Property address: 12510 Manning Trl N Hugo, MN 55038

Property address: 12510 Manning Trl N Hugo, MN 55038		Inspector initials/Date: TT 4/17/2019 (mm/dd/yyyy)	
		(
4. Soil Separation — Compliance co	omponent #4 of 5		
Date of installation:	☑ Unknown	Verification method(s):	
(mm/dd/yyyy)		Soil observation does not expire. Previous soil	
Shoreland/Wellhead protection/Food beverage lodging? Compliance criteria:	☐ Yes ☒ No	observations by two independent parties are sufficient, unless site conditions have been altered or local requirements differ.	
For systems built prior to April 1, 1996, and	☐ Yes ☐ No	Conducted soil observation(s) (Attach boring logs)	
not located in Shoreland or Wellhead		☐ Two previous verifications (Attach boring logs)	
Protection Area or not serving a food, beverage or lodging establishment:		Not applicable (Holding tank(s), no drainfield)	
Drainfield has at least a two-foot vertical		☐ Unable to verify (See Comments/Explanation)	
separation distance from periodically saturated soil or bedrock.		Other (See Comments/Explanation)	
Non-performance systems built April 1,	☐ Yes ☐ No	Comments/Explanation:	
1996, or later or for non-performance systems located in Shoreland or Wellhead Protection Areas or serving a food, beverage, or lodging establishment:		Unable to locate a drainfield	
Drainfield has a three-foot vertical separation distance from periodically saturated soil or bedrock.*			
"Experimental", "Other", or "Performance"	☐ Yes ☐ No	Indicate depths or elevations	
systems built under pre-2008 Rules; Type IV or V systems built under 2008 Rules (7080. 2350 or 7080.2400 (Advanced Inspector		A. Bottom of distribution media	
License required)		B. Periodically saturated soil/bedrock	
Drainfield meets the designed vertical separation distance from periodically saturated soil or bedrock.		C. System separation	
Any "no" answer above indicates to		D. Required compliance separation*	
failing to protect groundwater. 5. Operating Permit and Nitrogen		*May be reduced up to 15 percent if allowed by Local Ordinance. ance component #5 of 5 Not applicable	
Is the system operated under an Operating	Permit?	es 🛮 No If "yes", A below is required	
Is the system required to employ a Nitroger	n BMP?	es 🛮 No If "yes", B below is required	
BMP = Best Management Practice(s) s			
If the answer to both questions is "r			
Compliance criteria			
a. Operating Permit number: n/a			
Have the Operating Permit requireme	nts been met?	☐ Yes ☐ No	
b. Is the required nitrogen BMP in place		ning?	
Any "no" answer indicates Nonc			
Upgrade Requirements (Minn. Stat. § 115.55, discontinued within ten months of receipt of this ground water, the system must be upgraded, rep is not failing as defined in law, and has at least to	An imminent threat to p notice or within a shorter placed, or its use discont wo feet of design soil se	public health and safety (ITPHS) must be upgraded, replaced, or its use r period if required by local ordinance. If the system is failing to protect tinued within the time required by local ordinance. If an existing system paration, then the system need not be upgraded, repaired, replaced, or int. This provision does not apply to systems in shortland areas.	

www.pca.state.mn.us • 651-296-6300 • 800-657-3864 TTY 651-282-5332 or 800-657-3864 • Available in alternative formats wq-wwists4-31b • 6/4/14 Page 3 of 3

Wellhead Protection Areas, or those used in connection with food, beverage, and lodging establishments as defined in law.

12510 MANNING TRLN N HUGO, MN 55038 N

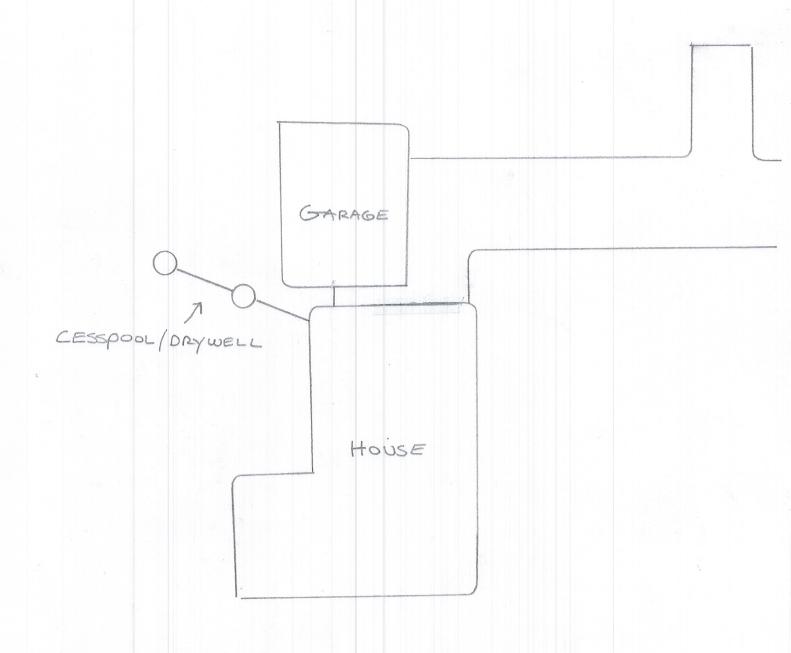

O WELL