

Compliance Boring Log

Date: 6/21/2019

Property Address: 9655 190th Street North, Forest Lake MN 55025

Property Owner name: Chad Collins


Boring 1		Location:		
Soil Horizons Depth	Color	Texture	Structure	Consistence
0-14"	10yr 3/2	Sandy Loam	Granular	Weak
14-55"	10yr 4/4	Clay Loam	Blocky	Firm
55-65"	10yr 4/3	Clay Loam	Platey	Firm
No Redox found				

Boring 2		Location:		
Soil Horizons Depth	Color	Texture	Structure	Consistence
			Friable	Weak
			Friable	Weak

THIS IS NOT A SURVEY
DATE: 6/21/19
9655 190TH ST N, FOREST LAKE

N

DEEP WELL 75'+

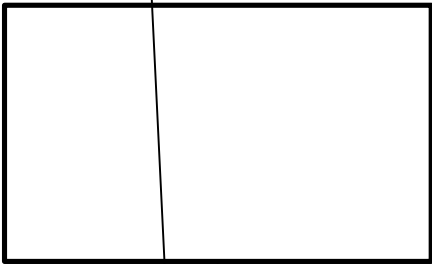

53'




1000 TANK

10'




1000 TANK

20'

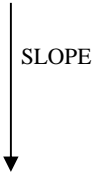

83'

82'

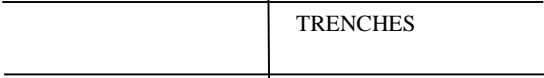

TRENCHES

B1

