


1250 GALLON  
 SEPTIC TANK  
 4.50 SQ FT. OF DI.  
 CAST IRON TO  
 TANK + FIRST BOX  
 PVC IN DI. S  
 3 LINES 50 FT.  
 LONG 3 FT WIDE

N

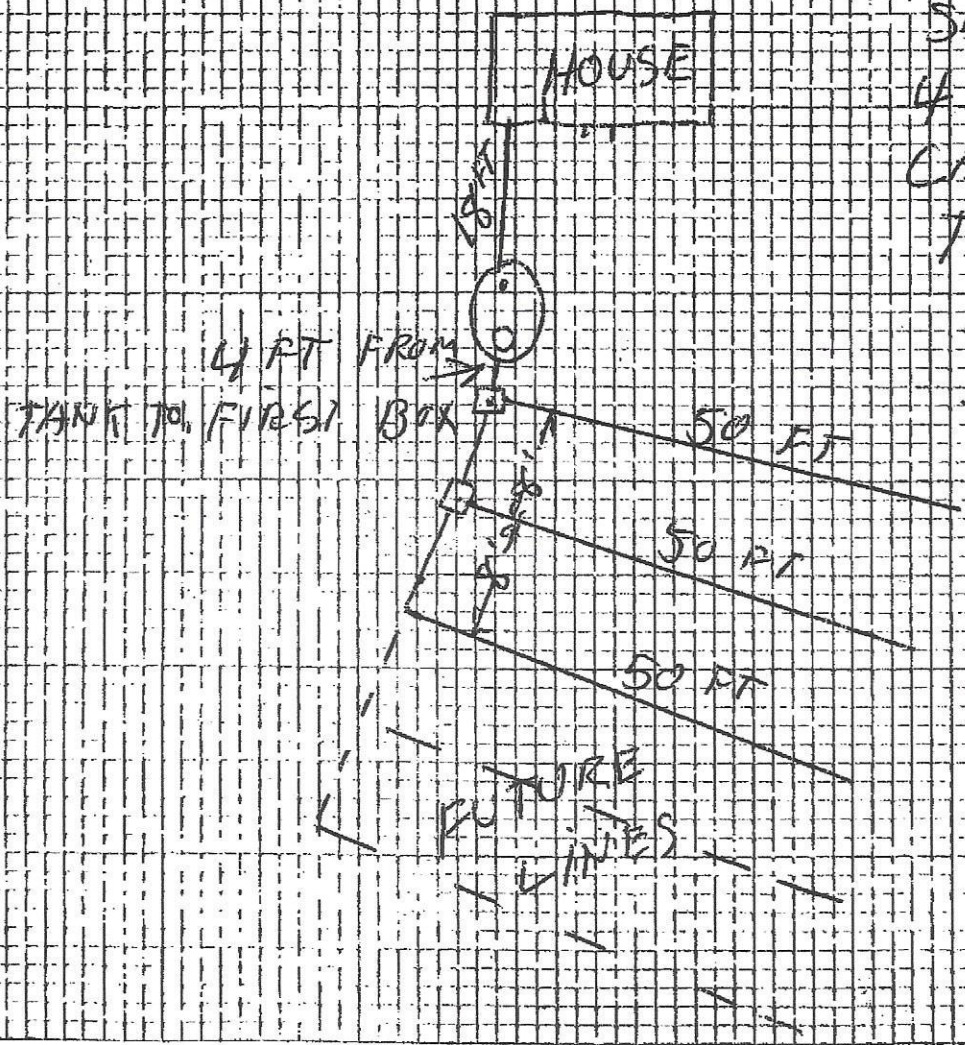

ON SITE SYSTEM - W CITY OF COTTAGE GROVE