

## Compliance Inspection Form

**Existing Subsurface Sewage Treatment Systems (SSTS)** 

Doc Type: Compliance and Enforcement


Inspection results based on Minnesota Pollution Control Agence	For local tracking purposes:
requirements and attached forms – additional local requirements m	
Submit completed form to Local Unit of Government (LUG) a within 15 days	nd system owner
System Status	
System status on date (mm/dd/yyyy): 8/13/2019	
Compliant – Certificate of Compliance (Valid for 3 years from report date, unless shorter time frame outlined in Local Ordinance.)	Noncompliant – Notice of Noncompliance (See Upgrade Requirements on page 3.)
Reason(s) for noncompliance (check all applicable	a)
☐ Impact on Public Health (Compliance Component #1) – Immin	
☐ Other Compliance Conditions (Compliance Compone	
☐ Tank Integrity (Compliance Component #2) – Failing	to protect groundwater
Other Compliance Conditions (Compliance Compone	
Soil Separation (Compliance Component #4) – Failin	
Operating permit/monitoring plan requirements (Com	pliance Component #5) – Noncompliant
Property Information Parcel	
	ID# or Sec/Twp/Range: 13.028.21.12.0002
Property address: 11559 Valley Creek Rd Woodbury, MN 5512	
Property owner: Stewart McKenna	Owner's phone: 612-490-1016
Owner's representative:	Representative phone:
Local regulatory authority: Washington County	Regulatory authority phone: _651-430-6655
Brief system description: 1250 gallon & 1000 gallon septic tank	
Certification	
I hereby certify that all the necessary information has been gather determination of future system performance has been nor can be possible abuse of the system, inadequate maintenance, or future	made due to unknown conditions during system construction.
Inspector name: Tom Trooien	Certification number: 323
Business name: All State Septic Services LLC	License number: 1568
Inspector signature: 70m7rooto	Phone number: 612-594-4496
Nocossary or Locally Beauty of Attachment	
Necessary or Locally Required Attachments	
Soil boring logs	☐ Forms per local ordinance
Other information (list):	
www.pca.state.mn.us • 651-296-6300 • 800-657-3864 • wq-wwists4-31b • 6/4/14	TTY 651-282-5332 or 800-657-3864 • Available in alternative formats  Page 1 of 4

sewage to the sewage to drain rs. vage backup into	Compliance compo  ☐ Yes ☒ No	Verification method(s):				
sewage to the sewage to drain rs. vage backup into		Verification method(s):				
sewage to the sewage to drain rs. vage backup into	☐ Yes ☒ No					
sewage to drain rs.	☐ Yes ☒ No					
rs. vage backup into		<ul> <li>☑ Searched for surface outlet</li> <li>☑ Searched for seeping in yard/backup in home</li> <li>☐ Excessive ponding in soil system/D-boxes</li> <li>☐ Homeowner testimony (See Comments/Explanation)</li> <li>☐ "Black soil" above soil dispersal system</li> </ul>				
	☐ Yes ☒ No					
hment.	☐ Yes ☒ No					
wer above ind nminent threa ety.		<ul> <li>☐ System requires "emergency" pumping</li> <li>☐ Performed dye test</li> <li>☐ Unable to verify (See Comments/Explanation)</li> <li>☐ Other methods not listed (See Comments/Explanation)</li> </ul>				
nation:		Street methods not histed (See Comments/Explanation)				
– Compliance	component #2 of 5	is a second of the second of t				
eria:		Verification method(s):				
a seepage pit, or leaching pit.	☐ Yes ⊠ No	□ Probed tank(s) bottom     □				
7080.2550 may be local ordinance.		<ul><li>☑ Examined construction records</li><li>☐ Examined Tank Integrity Form (Attach)</li></ul>				
k below their depth. le tank(s) leaks:	☐ Yes ⊠ No	<ul><li>Observed liquid level below operating depth</li><li>Examined empty (pumped) tanks(s)</li><li>Probed outside tank(s) for "black soil"</li></ul>				
Any "yes" answer above indicates the system is failing to protect groundwater.		☐ Unable to verify (See Comments/Explanation) ☐ Other methods not listed (See Comments/Explanation)				
ation:	ioanawater,					
nce Conditio	ns – Compliance com	nponent #3 of 5				
ole covers are dam	aged, cracked, unsecure	ed, or appear to be structurally unsound. ☐ Yes* ☒ No ☐ Unknow				
lectrical hazards, etc.)		versely impact public health or safety. ☐ Yes* ☒ No ☐ Unknow				
		ons as determined by inspector . ☐ Yes* ☐ No				
		otective of ground water for other conditio g to protect groundwater.				

www.pca.state.mn.us • 651-296-6300 • wq-wwists4-31b • 6/4/14

Property address: 11559 Valley Creek Rd Woodbury, MN 55129			Inspector initials/Date: TT   8/13/2019 (mm/dd/yyyy)		
4. Soil Separation - Compliance co	omponent #4 of 5				
Date of installation: 4/28/2004 (mm/dd/yyyy)	Unknown	Verification method(s):			
Shoreland/Wellhead protection/Food beverage lodging?	☐ Yes ☒ No	obser	Soil observation does not expire. Previous soil observations by two independent parties are sufficient, unless site conditions have been altered or local		
Compliance criteria:			ements differ.	en allered or local	
For systems built prior to April 1, 1996, and not located in Shoreland or Wellhead	☐ Yes ☐ No	<ul><li>☐ Conducted soil observation(s) (Attach boring logs)</li><li>☐ Two previous verifications (Attach boring logs)</li></ul>			
Protection Area or not serving a food, beverage or lodging establishment:  Drainfield has at least a two-foot vertical		<ul> <li>Not applicable (Holding tank(s), no drainfield)</li> <li>☐ Unable to verify (See Comments/Explanation)</li> <li>☐ Other (See Comments/Explanation)</li> </ul>			
					separation distance from periodically saturated soil or bedrock.
Non-performance systems built April 1,	☐ Yes ⊠ No				Comr
1996, or later or for non-performance		B-1 0-6 topsoil			
systems located in Shoreland or Wellhead Protection Areas or serving a food,					
beverage, or lodging establishment:		6-32 silt loam			
Drainfield has a three-foot vertical		32-60 silt loam			
separation distance from periodically saturated soil or bedrock.*		Redox depletions & concentrations at 30"			
		B-2	0-14 topsoil	10 YR 2/2	
			14-36 silt loam	7.5 YR 5/4	
			36- 60 silt loam	7.5 YR 4/6	
		Redo	depletions & concentra		
"Experimental", "Other", or "Performance" systems built under pre-2008 Rules; Type IV or V systems built under 2008 Rules (7080. 2350 or 7080.2400 (Advanced Inspector License required)	⊠ Yes □ No	A. Bo	ate depths or elevati	1.5	
Drainfield meets the designed vertical				1	
separation distance from periodically		C. Sys	stem separation		
saturated soil or bedrock.			quired compliance separation		
Any "no" answer above indicates to failing to protect groundwater.  Operating Permit and Nitrogen		Ordir	be reduced up to 15 perd nance. nponent #5 of 5	cent if allowed by Local  Not applicable	
Is the system operated under an Operating	Permit?  Yes	s 🖾 No	If "yes", A below is a	required	
Is the system required to employ a Nitroger		s 🛮 No			
BMP = Best Management Practice(s) s			y 00 , D Delow 18 1	Squiiou	
If the answer to both questions is "r			need to be completed	d.	
Compliance criteria					
a. Operating Permit number: n/a					
Have the Operating Permit requireme	nts been met?		☐ Yes ☐ No		
b. Is the required nitrogen BMP in place	and properly functioni	ng?	☐ Yes ☐ No		
Any "no" answer indicates Nonc					
/ww.pca.state.mn.us • 651-296-6300 • 8 /q-wwists4-31b • 6/4/14	00-657-3864 • TTY	/ 651-282-	5332 or 800-657-3864 •	Available in alternative forma	

**Upgrade Requirements** (Minn. Stat. § 115.55) An imminent threat to public health and safety (ITPHS) must be upgraded, replaced, or its use discontinued within ten months of receipt of this notice or within a shorter period if required by local ordinance. If the system is failing to protect ground water, the system must be upgraded, replaced, or its use discontinued within the time required by local ordinance. If an existing system is not failing as defined in law, and has at least two feet of design soil separation, then the system need not be upgraded, replaced, or its use discontinued, notwithstanding any local ordinance that is more strict. This provision does not apply to systems in shoreland areas, Wellhead Protection Areas, or those used in connection with food, beverage, and lodging establishments as defined in law.

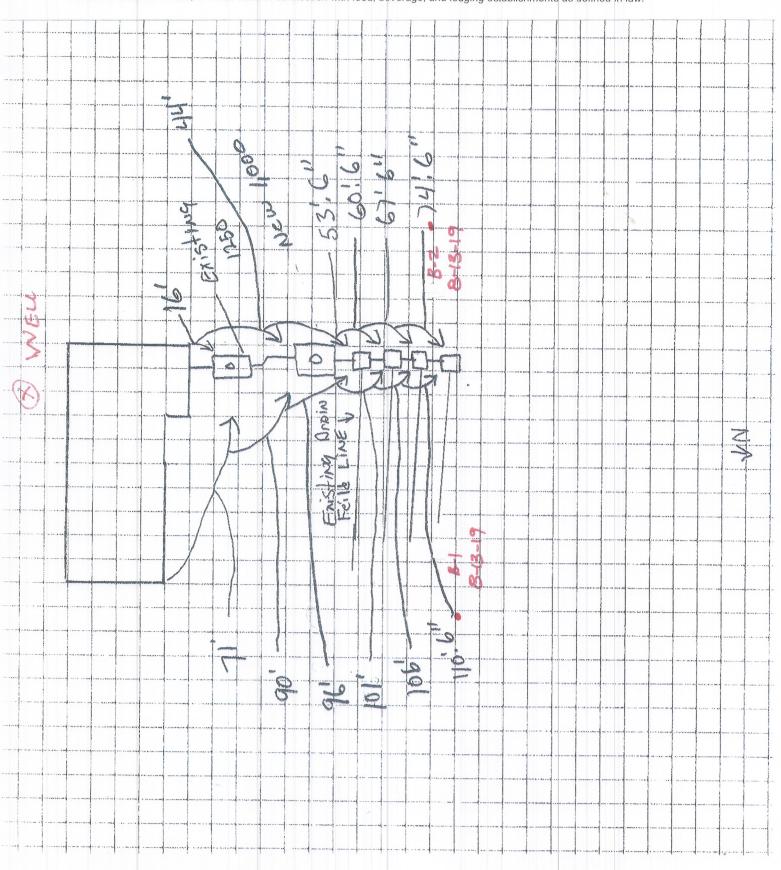

800-657-3864