CERTIFICATE OF SURVEY

FOR NORTHERN LAKES DEVELOPMENT

I HEREBY CERTIFY THAT THIS SURVEY, PLAN, OR REPORT WAS PREPARED BY ME OR UNDER MY DIRECT SUPERVISION AND THAT I AM A DULY REGISTERED LAND SURVEYOR UNDER THE LAWS OF THE STATE OF MINNESOTA.

MINNESOTA REGISTRATION NO. 20270

KURTH SURVEYING INC.
4002 JEFFERSON STREET N.E.
COLUMBIA HEIGHTS MINNESOTA 55421
612-788-9769

DATE 3-23-92
SCALE 1" = 100'
O = IRON MONUMENT SET ON OCT. 1, 1991
BEARINGS PER PLAT

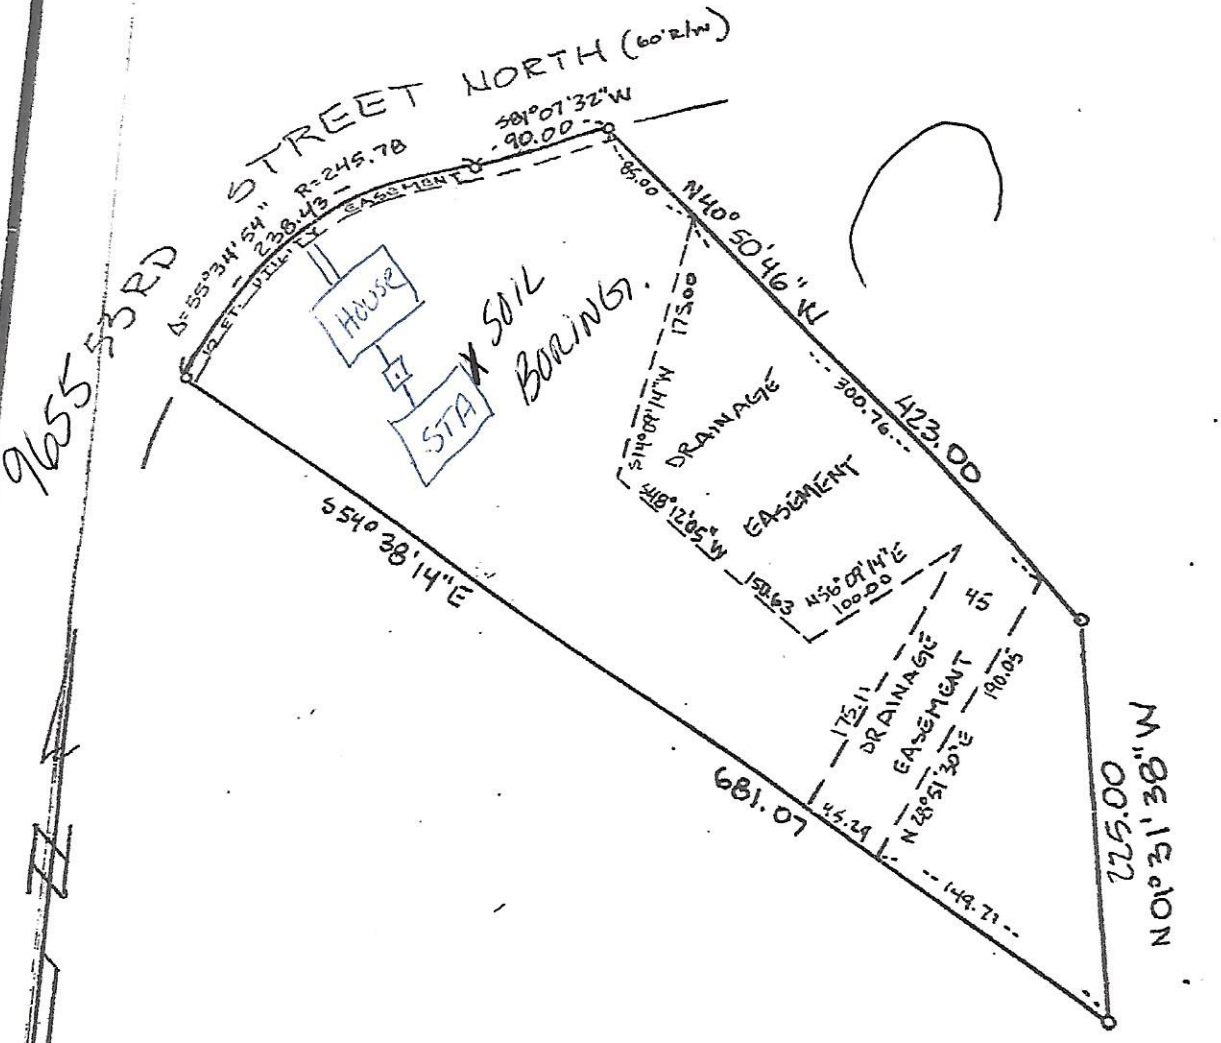

LOT 7, BLOCK 2,
ARABIAN HILLS,
WASHINGTON COUNTY, MN.

TOTAL P.02