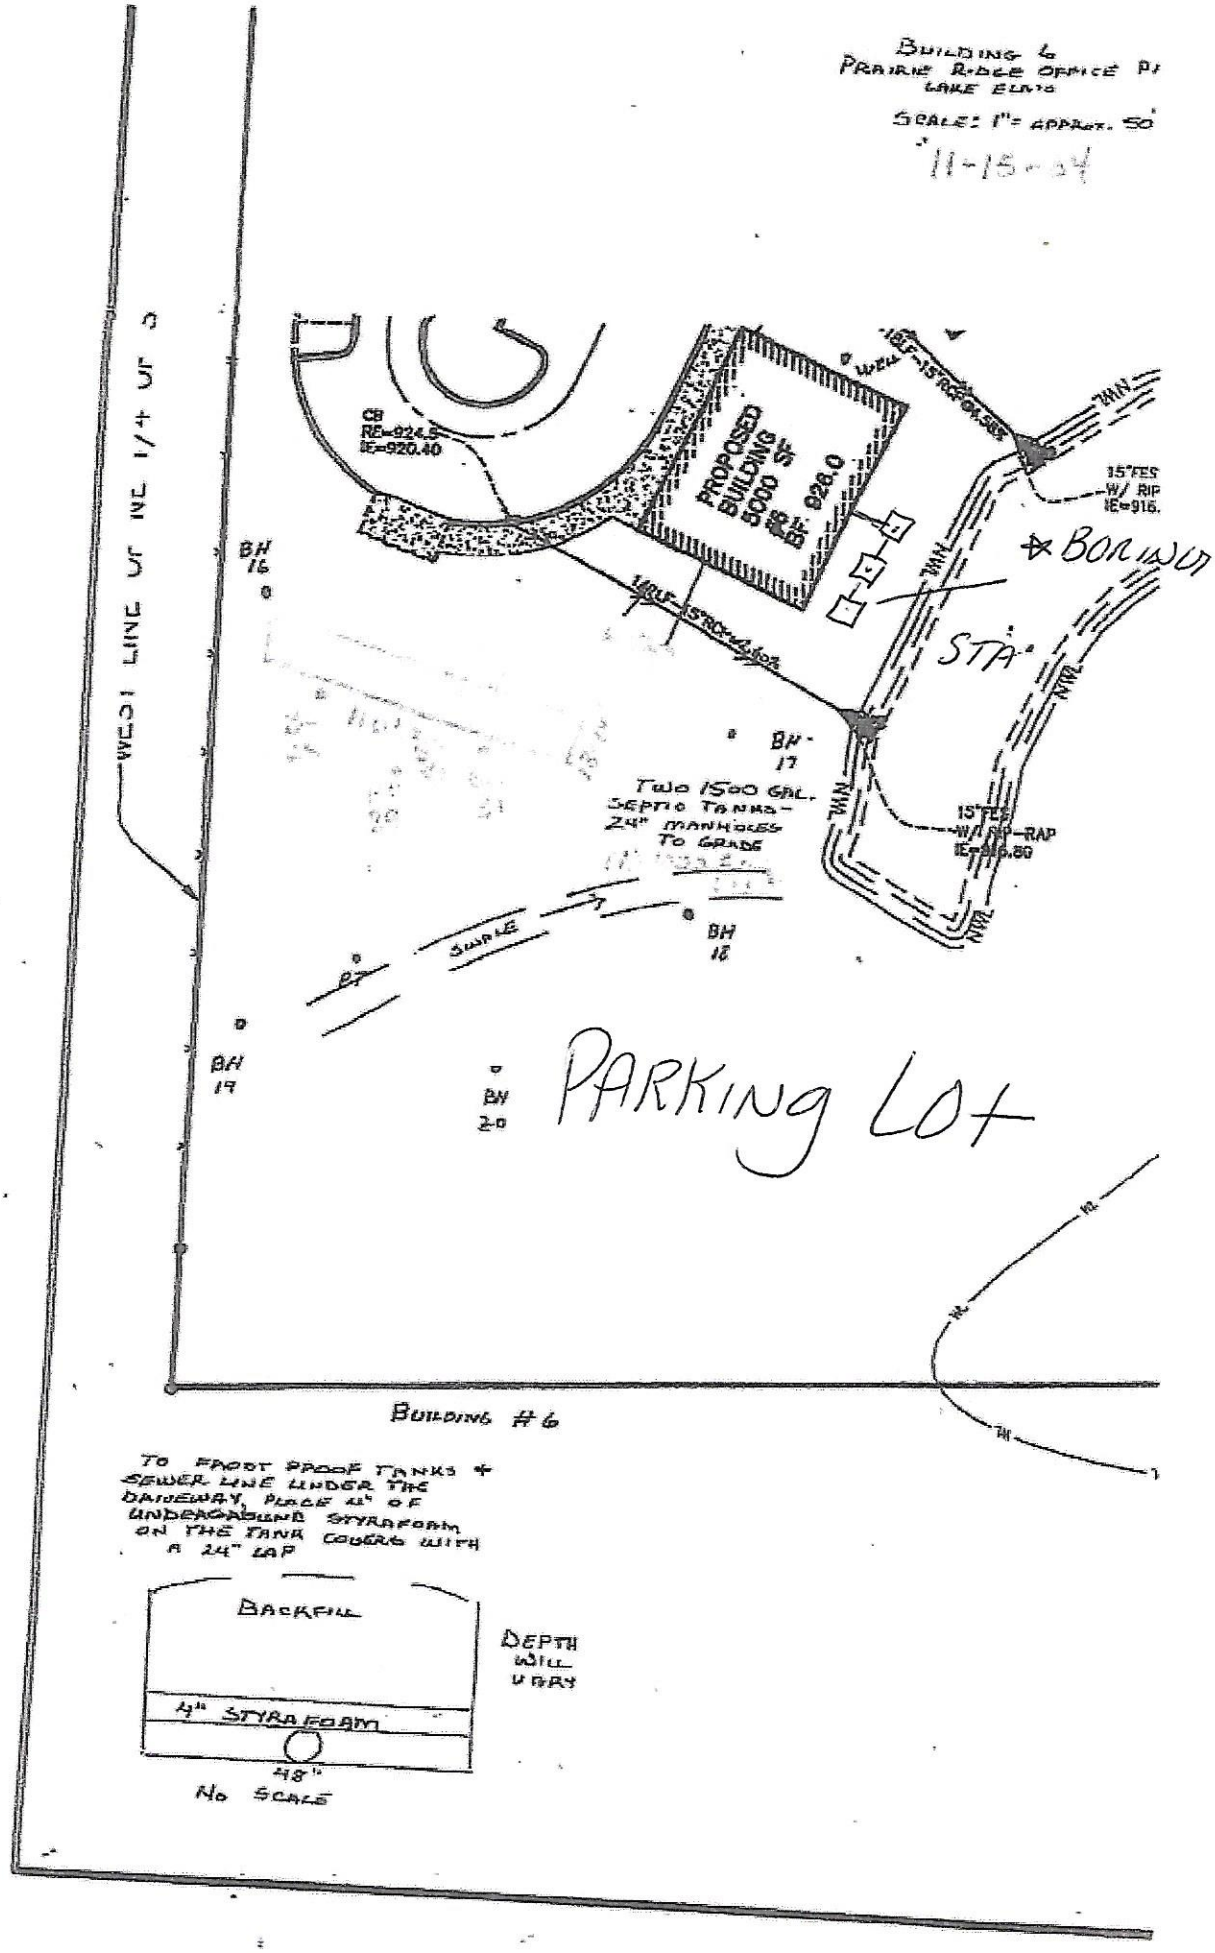
BUILDING 6
PRAIRIE RIDGE OFFICE PK
LAKE ELMO
SCALE: 1" = APPROX. 50'
11-15-04
WEST LINE OF NE 1/4 OF
CB
RE=924.5
IE=920.40
PROPOSED
BUILDING
5000 SQ. FT.
928.0
15" RCP @ 0.5%
15" FES
W/ RIP
IE=916.
BORING
STA
BH
16
BH
17
TWO 1500 GAL.
SEPTIC TANKS -
24" MANHOLES
TO GRADE
15" FES
W/ RIP-RAP
IE=916.80
SWALE
BH
18
BH
19
BH
20
PARKING LOT
BUILDING #6
TO FROST PROOF TANKS &
SEWER LINE UNDER THE
DRIVEWAY, PLACE 4" OF
UNDERGROUND STYROFOAM
ON THE TANK COVERS WITH
A 24" LAP
BACKFILL
4" STYROFOAM
48"
DEPTH
WILL
VARY
No SCALE