


Drainfield Area

B-1 By Inspect MN O

Distribution Box *SOIL BORING

Septic Tank

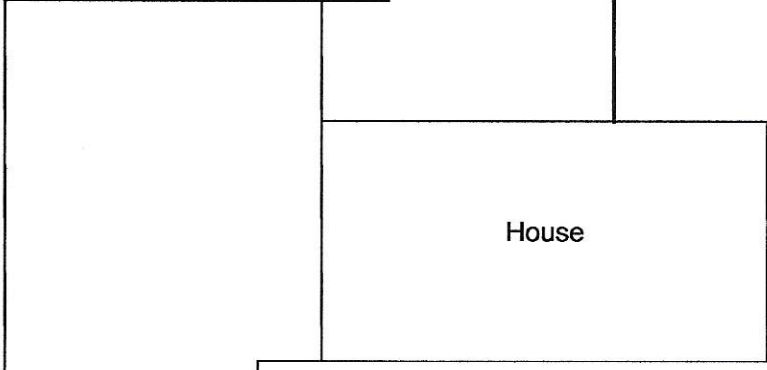

1660 Queens Ave S, Lake St. Croix Beach, MN 55043

NO SCALE

CITY WATER
NO WELL