
Midwest Sewer Services

P.O. Box 10853 White Bear Lake, MN 55110
651-492-7550/Brian@Midwestsoiltesting.com

Brian Humpal
MPCA Licensed Advanced Inspector

SUBSURFACE SEWAGE TREATMENT SYSTEM (SSTS) COMPLIANCE REPORT

Date: August 13, 2020

Time: 1:00 PM

Owner: Tom & Karen Howe

Inspection Address: 7959 Quadrant Ave S, Denmark Twp, MN 55033

REPORT SUMMARY

I have performed an “MPCA Compliance Inspection” on this system and have reviewed the original design/permit records on file at Washington County. This system consists of two pre-cast septic tanks, a pre-cast lift tank, and a chamber trench drainfield.

Although not a compliance criteria, it should be noted that the lift tank manhole cover should be replaced due to it having pieces breaking off. In addition, the septic tanks and lift tank are currently due for maintenance pumping and should be pumped when possible.

Predicated on my inspection of the system and my review of the original design/permit records, it is my opinion that this system presently meets MPCA minimum compliance inspection requirements.

Midwest Sewer Services have been hired to perform a compliance inspection of this SSTS for compliance with local ordinances pursuant to Minn. Stat. § 115.55 (2013). This compliance inspection covers only the criteria required by Minn. Stat. § 115.55 Subd. 5a (2013) and Minn. R. 7080.1500 (2011). A compliance inspection is an indication of the current compliance status of the system and does not guarantee the performance or longevity of this system beyond the date of inspection, as it is impossible to determine the future performance of any system. Midwest Sewer Services disclaim any use of this compliance inspection beyond determining SSTS compliance pursuant to Minn. Stat. § 115.55 Subd. 5a (2013) and Minn. R. 7080.1500 (2011).

Please contact me should you have any questions.



Christopher Uebe



Brian Humpal


**Minnesota Pollution
Control Agency**

 520 Lafayette Road North
St. Paul, MN 55155-4194

Compliance Inspection Form

Existing Subsurface Sewage Treatment Systems (SSTS)

Doc Type: Compliance and Enforcement

Instructions: Inspection results based on Minnesota Pollution Control Agency (MPCA) requirements and attached forms – additional local requirements may also apply.

For local tracking purposes:

Submit completed form to Local Unit of Government (LUG) and system owner within 15 days

System Status

 System status on date (mm/dd/yyyy): 8/13/2020
 Compliant – Certificate of Compliance
(Valid for 3 years from report date, unless shorter time frame outlined in Local Ordinance.)
 Noncompliant – Notice of Noncompliance
(See Upgrade Requirements on page 3)

Reason(s) for noncompliance (check all applicable)

- Impact on Public Health (Compliance Component #1) – Imminent threat to public health and safety
- Other Compliance Conditions (Compliance Component #3) – Imminent threat to public health and safety
- Tank Integrity (Compliance Component #2) – Failing to protect groundwater
- Other Compliance Conditions (Compliance Component #3) – Failing to protect groundwater
- Soil Separation (Compliance Component #4) – Failing to protect groundwater
- Operating permit/monitoring plan requirements (Compliance Component #5) – Noncompliant

Property Information

Parcel ID# or Sec/Twp/Range: _____

 Property address: 7959 Quadrant Ave S, Denmark Twp, MN 55033 Reason for inspection: Property Transfer

 Property owner: Tom & Karen Howe Owner's phone: _____

 or
 Owner's representative: _____ Representative phone: _____

 Local regulatory authority: Washington County Regulatory authority phone: 651-430-6655

 Brief system description: Two pre-cast septic tanks, a pre-cast lift tank, and a chamber trench drainfield.

Comments or recommendations:

Although not a compliance criteria, it should be noted that the lift tank manhole cover should be replaced due to it having pieces breaking off. In addition, the septic tanks and lift tank are currently due for maintenance pumping and should be pumped when possible.

Certification

I hereby certify that all the necessary information has been gathered to determine the compliance status of this system. No determination of future system performance has been nor can be made due to unknown conditions during system construction, possible abuse of the system, inadequate maintenance, or future water usage.

 Inspector name: Brian Humpal/Christopher Uebe Certification number: C5342/C9852

 Business name: Midwest Sewer Services License number: L2896

 Inspector signature: *Brian Humpal* Phone number: 651-492-7550

Necessary or Locally Required Attachments

- Soil boring logs System/As-built drawing Forms per local ordinance
- Other information (list): Report Summary, Property Information, Disclaimer, License

Property address: 7959 Quadrant Ave S, Denmark Twp, MN 55033

Inspector initials/Date: 8/13/2020 *BACU***1. Impact on Public Health – Compliance component #1 of 5****Compliance criteria:**

System discharge sewage to the ground surface.	<input type="checkbox"/> Yes <input checked="" type="checkbox"/> No
--	---

System discharge sewage to drain tile or surface waters.	<input type="checkbox"/> Yes <input checked="" type="checkbox"/> No
--	---

System cause sewage backup into dwelling or establishment.	<input type="checkbox"/> Yes <input checked="" type="checkbox"/> No
--	---

Any "yes" answer above indicates the system is an Imminent Threat to Public Health and Safety.

Comments/Explanation:

None of the above found.

Verification method(s):

- Searched for surface outlet
- Searched for seeping in yard/backup in home
- Excessive ponding in soil system/D-boxes
- Homeowner testimony (See Comments/Explanation)
- "Black soil" above soil dispersal system
- System requires "emergency" pumping
- Performed dye test
- Unable to verify (See Comments/Explanation)
- Other methods not listed (See Comments/Explanation)

2. Tank Integrity – Compliance component #2 of 5**Compliance criteria:**

System consists of a seepage pit, cesspool, drywell, or leaching pit.	<input type="checkbox"/> Yes <input checked="" type="checkbox"/> No
---	---

Seepage pits meeting 7080.2550 may be compliant if allowed in local ordinance.

Sewage tank(s) leak below their designed operating depth.	<input type="checkbox"/> Yes <input checked="" type="checkbox"/> No
---	---

If yes, which sewage tank(s) leaks:	
-------------------------------------	--

Any "yes" answer above indicates the system is Failing to Protect Groundwater.

Comments/Explanation:

Lowered underwater camera into tanks - baffles and tank walls OK. Lift pump and alarm were operational at the time of the inspection. Although not a compliance criteria, it should be noted that the lift tank manhole cover should be replaced due to it having pieces breaking off. In addition, the septic tanks and lift tank are currently due for maintenance pumping and should be pumped when possible.

Verification method(s):

- Probed tank(s) bottom
- Examined construction records
- Examined Tank Integrity Form (Attach)
- Observed liquid level below operating depth
- Examined empty (pumped) tanks(s)
- Probed outside tank(s) for "black soil"
- Unable to verify (See Comments/Explanation)
- Other methods not listed (See Comments/Explanation)

3. Other Compliance Conditions – Compliance component #3 of 5

- a. Maintenance hole covers are damaged, cracked, unsecured, or appear to structurally unsound. Yes* No Unknown
- b. Other issues (electrical hazards, etc.) to immediately and adversely impact public health or safety. Yes* No Unknown
***System is an imminent threat to public health and safety**

Explain:

- c. System is non-protective of ground water for other conditions as determined by inspector Yes* No
***System is failing to protect groundwater**

Explain:

Property address: 7959 Quadrant Ave S, Denmark Twp, MN 55033

Inspector initials/Date: 8/13/2020 *BAU*

4. Soil Separation – Compliance component #4 of 5

Date of installation: 2007 Unknown
 Shoreland/Wellhead protection/Food Beverage Lodging? Yes No

Compliance criteria:

For systems built prior to April 1, 1996, and not located in Shoreland or Wellhead Protection Area or not serving a food, beverage or lodging establishment: Yes No

Drainfield has at least a two-foot vertical separation distance from periodically saturated soil or bedrock.

Non-performance systems built April 1, 1996, or later or for non-performance systems located in Shoreland or Wellhead Protection Areas or serving a food, beverage, or lodging establishment: Yes No

Drainfield has a three-foot vertical separation distance from periodically saturated soil or bedrock.*

“Experimental”, “Other”, or “Performance” systems built under pre-2008 Rules; Type IV or V systems built under 2008 Rules (7080.2350 or 7080.2400 (Advanced Inspector License required) Yes No

Drainfield meets the designed vertical separation distance from periodically saturated soil or bedrock.

Any “no” answer above indicates the system is Failing to Protect Groundwater.

Verification method(s):

Soil observation does not expire. Previous soil observations by two independent parties are sufficient, unless site conditions have been altered or local requirements differ.

- Conducted soil observation(s) (Attach boring logs)
- Two previous verifications (Attach boring logs)
- Not applicable (Holding tank(s), no drainfield)
- Unable to verify (See Comments/Explanation)
- Other (See Comments/Explanation)

Comments/Explanation:

Reviewed design and permit records.

Indicate depths of elevations

A. Bottom of distribution media	See Attached Boring Log(s)
B. Periodically saturated soil/bedrock	
C. System separation	
D. Required compliance separation*	

*May be reduced up to 15 percent if allowed by Local Ordinance.

5. Operating Permit and Nitrogen BMP* – Compliance component #5 of 5 Not applicable

Is the system operated under an Operating Permit? Yes No **If “yes”, A below is required**

Is the system required to employ a Nitrogen BMP? Yes No **If “yes”, B below is required**

BMP=Best Management Practice(s) specified in the system design

If the answer to both questions is “no”, this section does not need to be completed.

Compliance criteria

a. Operating Permit number: _____ Have the Operating Permit requirements been met?	<input type="checkbox"/> Yes <input type="checkbox"/> No
b. Is the required nitrogen BMP in place and properly functioning?	<input type="checkbox"/> Yes <input type="checkbox"/> No

Any “no” answer indicates Noncompliance.

Upgrade Requirements (Minn. Stat. § 115.55) An imminent threat to public health and safety (ITPHS) must be upgraded, replaced, or its use discontinued within ten months of receipt of this notice or within a shorter period if required by local ordinance. If the system is failing to protect ground water, the system must be upgraded, replaced, or its use discontinued within the time required by local ordinance. If an existing system is not failing as defined in law, and has at least two feet of design soil separation, then the system need not be upgraded, repaired, replaced, or its use discontinued, notwithstanding any local ordinance that is more strict. This provision does not apply to systems in shoreland areas, Wellhead Protection Areas, or those used in connection with food, beverage, and lodging establishments as defined in law.

5 of 13
Midwest Sewer Testing

Subsurface Sewage Treatment System Owner/Property Information


This information will be used for the purpose of conducting an MPCA Compliance Inspection.

Date of Inspection: August 13, 2020		Time: 1:00 PM																													
Property Address: 7959 Quadrant Ave S, Denmark Twp, MN		Zip: 55033																													
Property Owner: Tom & Karen Howe		Phone:																													
<table style="width: 100%; border: none;"> <tr> <td style="width: 25%;"><u>Tank(s)</u></td> <td style="width: 25%;"><u>Tank(s)Material</u></td> <td style="width: 25%;"><u>Soil Treatment System</u></td> <td style="width: 25%;"><u>Other</u></td> </tr> <tr> <td><input checked="" type="checkbox"/>Septic 2</td> <td><input type="checkbox"/>Fiberglass</td> <td><input type="checkbox"/>Rock trench</td> <td><input type="checkbox"/>Alternative system _____</td> </tr> <tr> <td><input type="checkbox"/>Aerobic</td> <td><input type="checkbox"/>Plastic</td> <td><input type="checkbox"/>Gravelless trench</td> <td><input type="checkbox"/>Experimental system _____</td> </tr> <tr> <td><input checked="" type="checkbox"/>Lift</td> <td><input type="checkbox"/>Metal</td> <td><input checked="" type="checkbox"/>Chamber trench</td> <td><input type="checkbox"/>Cesspool system _____</td> </tr> <tr> <td><input type="checkbox"/>Holding</td> <td><input checked="" type="checkbox"/>Concrete</td> <td><input type="checkbox"/>Seepage bed</td> <td><input type="checkbox"/>Other system _____</td> </tr> <tr> <td><input type="checkbox"/>Other:</td> <td><input type="checkbox"/>Block</td> <td><input type="checkbox"/>Mound</td> <td>_____</td> </tr> <tr> <td></td> <td><input type="checkbox"/>Other _____</td> <td><input type="checkbox"/>At-grade</td> <td>_____</td> </tr>type="checkbox"/> Block	<input type="checkbox"/> Mound	_____		<input type="checkbox"/> Other _____	<input type="checkbox"/> At-grade	_____	<p>Are the tank maintenance covers accessible? <input checked="" type="checkbox"/> Yes <input type="checkbox"/> No *If no, proper maintenance must be performed through the maintenance holes. Maintenance hole covers should be made accessible to the ground surface to facilitate access and proper maintenance of the system.</p>		
Year house built: 2007	Year septic installed: 2007	Tank size (gals.): 2-1000																													
How long has seller owned the property?		Number of residents in home?																													
Number of bedrooms? 4	Are all floors drained by gravity? Y																														
Garbage disposal?	Whirlpool bath?																														
More than one system (laundry, etc.)?																															
Does this property have any footing drain tiles connected to the septic system?																															
Are any buildings on this property such as garages or out-buildings connected to this system?																															
Are there any additional systems on this property serving other buildings?																															
Location of septic system on lot? Tanks - East Side, Drainfield - North Side																															
Location of water well on lot?		Is the well a deep well? Y																													
Have you ever experienced any problems with the system such as: tree roots, sewage back-ups, surfacing of sewage onto the ground, septic tank overflowing, etc.; or have any repairs been made to the system? If yes, explain:																															
When was the system last pumped? 2013?		Name of pumper:																													
How often pumped in previous years? Due		Is system on a monitoring plan?																													
Have you received notices from any government agency concerning this system?																															
Is your property located in a shoreland management area? N																															
Do you have any additional information that should be given to the new owner?																															

I hereby certify that the above information is correct to the best of my knowledge. I also understand that if the system is considered "non-compliant/failing" per MPCA rules, that the inspector must by law submit a copy of this report to the local government unit within 15 days of the date of inspection completion. I also agree that unless otherwise noted in this report, that I/we are ultimately responsible for payment of all fees for all work performed relative to this inspection by Inspect Minnesota and Midwest Soil Testing

Owner/Occupant: _____

Date: _____

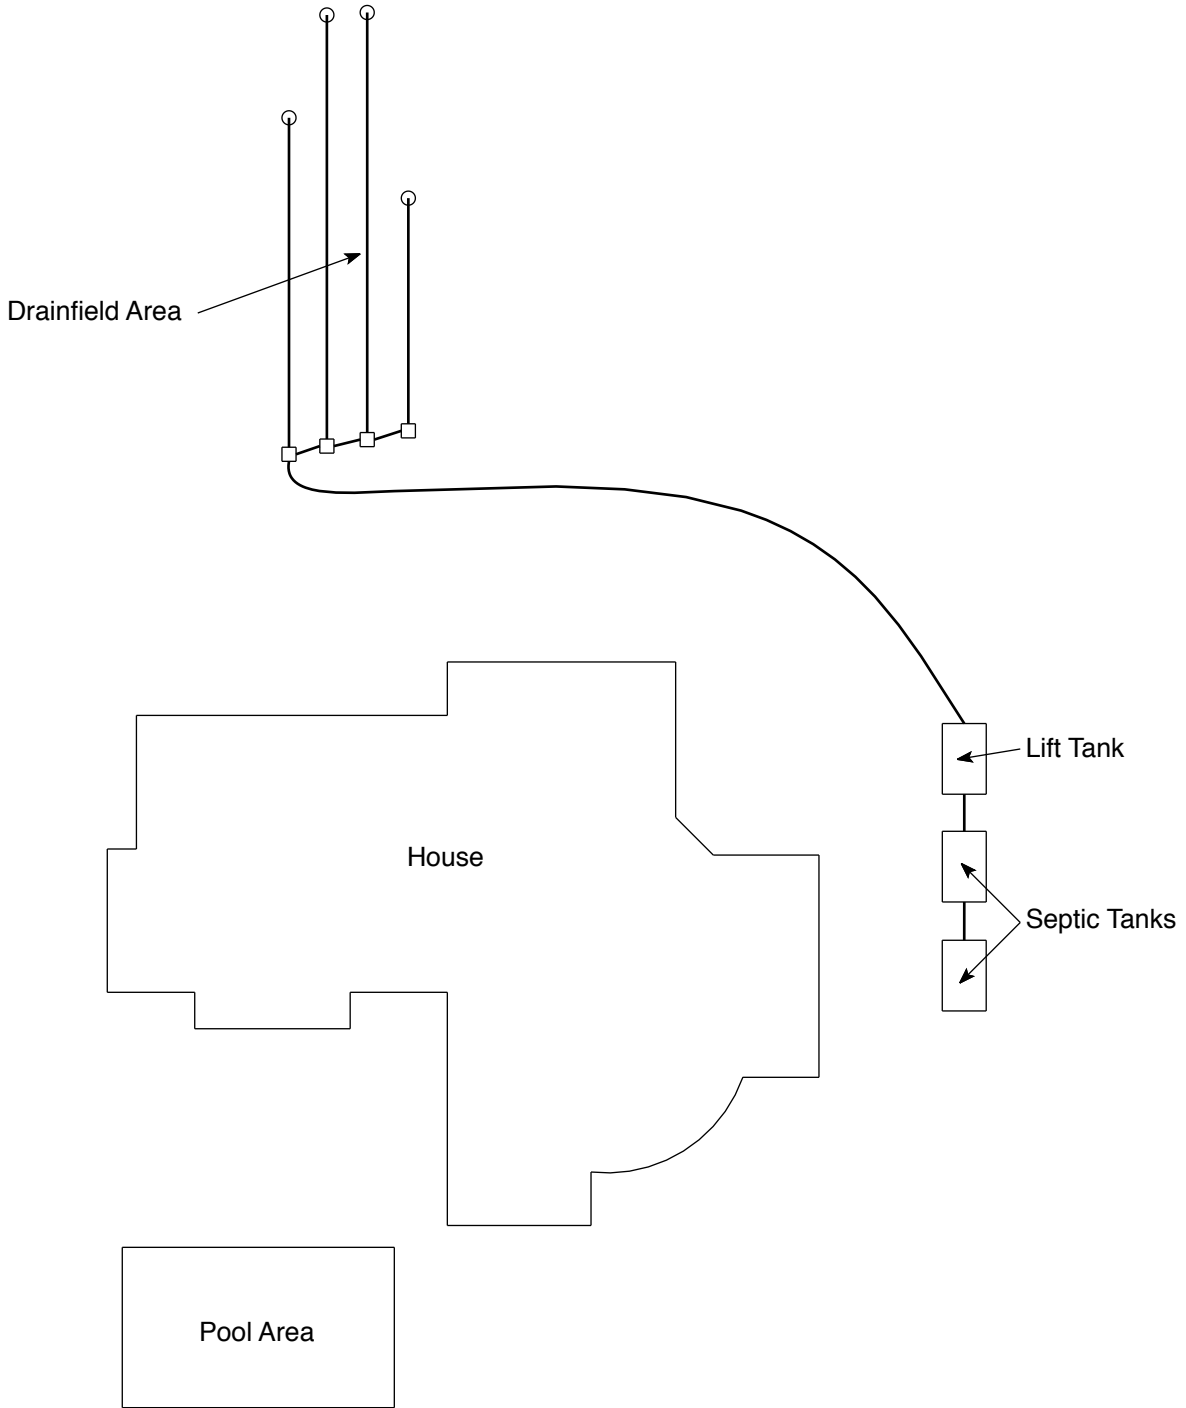

NO SCALE

7959 Quadrant Ave S, Denmark Twp, MN 55033


- Soil Borings -
7 of 13

Soil borings are made in order to determine the type and structure of soils at various depths as well as the location of the water table, impervious strata or bedrock.

Borings are most easily made with a hand auger, however other expedients may be utilized - back hoe, post hole auger, etc.

Soils encountered at various depths should be listed as to appearance, texture and composition.

Depth at which water, bedrock or heavy clay layer is encountered should be recorded.

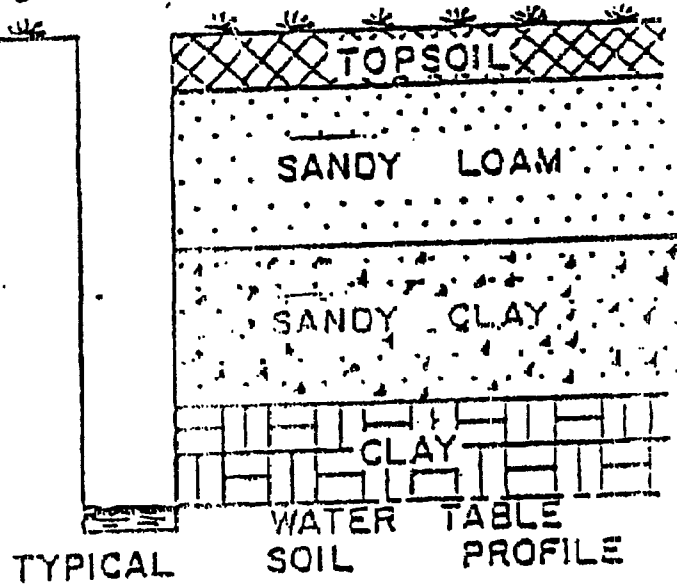

Soil Borings done by J. Bush, MPCA Certification
Number 389, on 10-16-07
(date)

LOG OF SOIL BORINGS

BORING NO. 1		BORING NO. 2		BORING NO. 3		BORING NO. 4	
DEPTH IN FEET	SOIL DESCRIPTION	DEPTH IN FEET	SOIL DESCRIPTION	DEPTH IN FEET	SOIL DESCRIPTION	DEPTH IN FEET	SOIL DESCRIPTION
0	6" BLACK LOAM TOPSOIL	0	6" LOAM TOPSOIL	0	6" LOAM TOPSOIL	0	
1/2		1/2	RED BROWN SILT LOAM	1/2		1/2	
1	MEDIUM BROWN SILT LOAM	1		1	RED BROWN SILT LOAM	1	
1 1/2		1 1/2	5 YR 4/3	1 1/2		1 1/2	
2	26" 10 YR 4/3	2		2	5 YR 5/3	2	
2 1/2	RED BROWN SANDY LOAM	2 1/2	30"	2 1/2		2 1/2	
3		3	RED BROWN SILT LOAM	3		3	
3 1/2	5 YR 4/3	3 1/2	5 YR 5/3	3 1/2		3 1/2	
4		4		4	48"	4	
4 1/2	54"	4 1/2		4 1/2		4 1/2	
5		5	60"	5		5	
5 1/2		5 1/2		5 1/2		5 1/2	
6		6		6		6	
6 1/2		6 1/2		6 1/2		6 1/2	
7		7		7		7	
7 1/2		7 1/2		7 1/2		7 1/2	
8		8		8		8	
8 1/2		8 1/2		8 1/2		8 1/2	
9		9		9		9	

18 MAY 2007 13:55 8 of 13
BORING BETWEEN B1-A & B3-A

0" - 9"	SILT LOAM	10 YR 3/2
9" - 32"	SILT LOAM	10 YR 4/4
32" - 41"	LOAMY FINE SAND	7.5 YR 4/4
41" -	LOAMY FINE SAND	10 YR 6/4 W/ PEDOX

LOG OF SOIL BORINGS

Job: 7959 Quadrant Ave. So. Denmark Township



Date: 4-26-07

N 44° 50.076' W 92° 46.313' B-5A Depth in Feet	N 44° 50.067' W 92° 46.270' B1-A	N 44° 50.069' W 92° 46.254' B2-A	N 44° 50.083' W 92° 46.276' B3-A	N 44° 55.083' W 92° 46.302' B4-A
Black loam 4	Black loam topsoil 9	Black loam 10	Black loam 6	Dark brown loam topsoil 7
Red brown 1				Red brown
silty clay loam 5yr 4/3 2	Medium brown silt loam 10yr 4/3	Red brown sandy loam 5yr 4/3	Red brown silt loam	Sandy silt loam 5yr 4/3 22
	Limestone Rock 28 Red brown sandy loam 5yr 4/3 36	Limestone Rock 25 Restriction at 27"	5yr 4/3 36	Limestone Rock 25 Restriction at 25"
	Red brown silt loam 5yr 4/3 4		Red brown silt loam	
	Medium brown fine sand 50		5yr 5/3 53 Limestone sand and rock 60	
	10yr 4/3 65 White sandstone		Restriction at 60" 10yr 5/6	
7				

Logs of Soil Borings

B-31

Location or Project 7954 Quadrant Ave-S.
 Borings made by J. GILL Date 8-8-03
 Classification System: AASHTO ; USDA-SCS X; Unified ; other
 Auger used (check two): Hand X, or Power ; Flight , or Bucket X; other

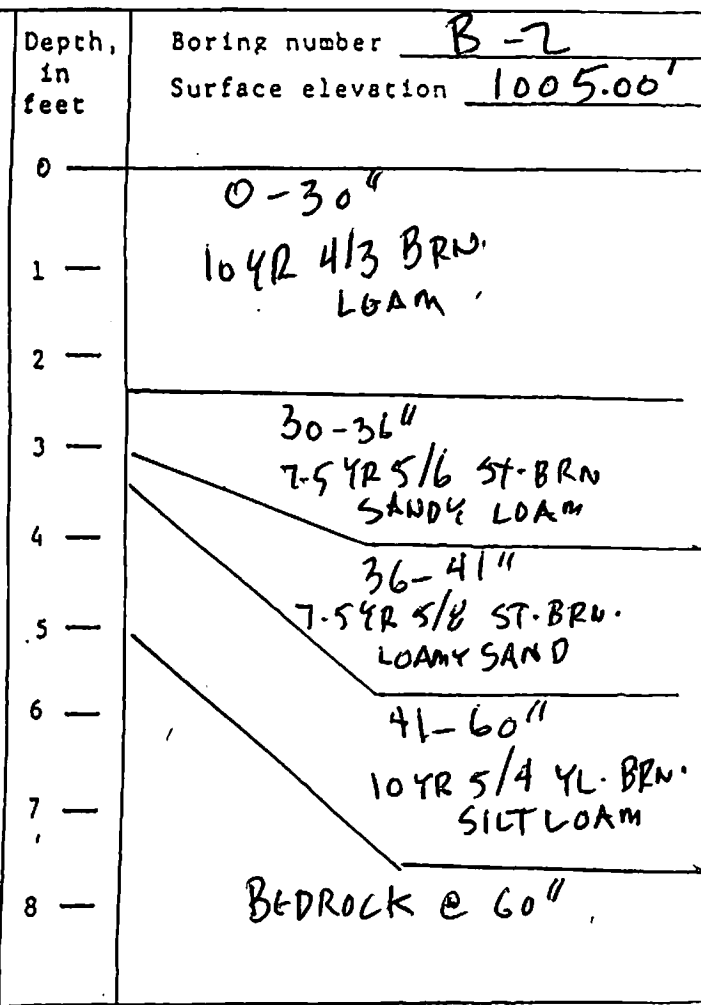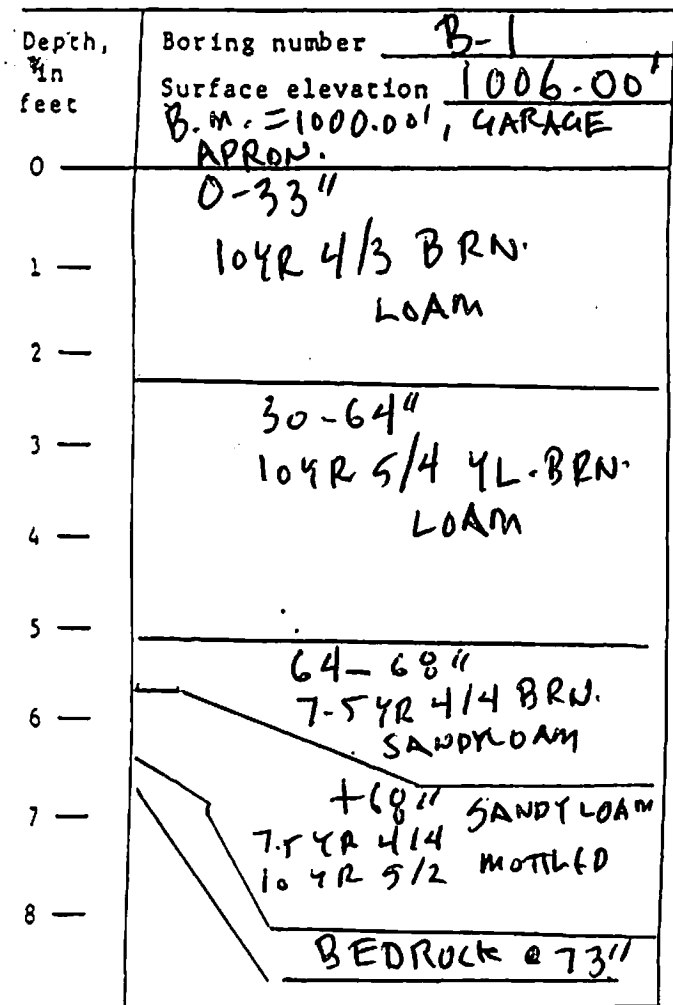

End of boring at 73"
 Standing water table:
 Present at feet of depth,
 hours after boring.
 Not present in boring hole X.
 Mottled soil:
 Observed at 60" of depth.
 Not present in boring hole .
 Observations and comments:

End of boring at 60"
 Standing water table:
 Present at feet of depth,
 hours after boring.
 Not present in boring hole X.
 Mottled soil:
 Observed at 60" of depth.
 Not present in boring hole .
 Observations and comments:

TOP OF DISTRIBUTION MEDIUM AT: INCHES
 BOTTOM OF DISTRIBUTION MEDIUM AT: INCHES
 REMARKS: DESIGN BORINGS
 WERE SOIL SAMPLES SPRAYED? YES X NO

Logs of Soil Borings

Location or Project 7959 Q Rednant Ave S
 Borings made by J. Hill Date 9-8-03
 Classification System: AASHO X; USDA-SCS X; Unified ; other
 Auger used (check two): Hand X, or Power ; Flight , or Bucket X; other

Depth, in feet	Boring number <u>B-3</u>
	Surface elevation <u> </u>
0	
1	0-33" 10 YR 4/3 BRN. LOAM
2	
3	33-50" 7.5 YR 5/6 ST BRN SILT LOAM
4	
5	+50" BEDROCK
6	
7	
8	

Depth, in feet	Boring number <u>B-4</u>
	Surface elevation <u>1004.00</u>
0	BM = 1000.00 Garage Apron
1	0-38" 10 YR 4/3 BRN. LOAMY SAND
2	
3	38-50" 7.5 YR 4/4 BRN. SANDY LOAM
4	
5	50-58" 10 YR 3/4 DK YL BRN. CLAY LOAM
6	
7	+58" CLAY LOAM 10 YR 3/4 7.5 YR 3/4 MOTTLED 2.5 YR 5/6
8	
	Bedrock @ 60"

End of boring at 50" ~~feet~~.
 Standing water table:
 Present at feet of depth,
 hours after boring.
 Not present in boring hole X.
 Mottled soil: BEDROCK
 Observed at 50" ~~feet~~ of depth.
 Not present in boring hole .
 Observations and comments:

End of boring at 6 feet.
 Standing water table:
 Present at feet of depth,
 hours after boring.
 Not present in boring hole X.
 Mottled soil:
 Observed at 58" ~~feet~~ of depth.
 Not present in boring hole .
 Observations and comments:

TOP OF DISTRIBUTION MEDIUM AT: INCHES
 BOTTOM OF DISTRIBUTION MEDIUM AT: INCHES
 REMARKS: DESIGN BORING
 WERE SOIL SAMPLES SPRAYED? YES X NO

DISCLAIMER

Brian L. Humpal, Inc. dba. Midwest Sewer Services, Inspect Minnesota, Midwest Soil Testing Relative to Subsurface Sewage Treatment System (SSTS) Compliance Inspections

1. This inspection/report is being performed for only the seller/owner of the property on which the SSTS is located. In such case that another party is paying for the inspection, the contract is between only said party and Brian L. Humpal, Inc.; there is no contract between Brian L. Humpal, Inc. and any other party unless otherwise noted.
3. Brian L. Humpal, Inc. has not been retained to warranty, guarantee, or certify the proper functioning of the SSTS for any period of time beyond the date of inspection or into the future. Because of the numerous factors (usage, maintenance, soil characteristics, previous failures, etc.) which may affect the proper operation of an SSTS, as well as the inability of Brian L. Humpal, Inc. to supervise or monitor the use or maintenance of the SSTS, the report shall not be construed as a warranty by Brian L. Humpal, Inc. that the SSTS will function properly for any particular party for any period of time.
4. Brian L. Humpal, Inc. is unable to verify the frequency and/or, quality of prior or future maintenance of the SSTS. Maintenance of the tank(s) must be performed through the tanks maintenance hole. The removal of solids from any location other than the maintenance hole is not a compliant method of maintenance. It is strongly recommended that maintenance covers be made accessible to the ground surface to facilitate proper maintenance.
5. Minimum Compliance Inspection requirements relative to this inspection and this report include only verification that the SSTS has tank(s) (septic tanks, lift tanks, dosing tanks, stilling tanks, etc.) which are watertight below the designed operating depth, the required separation between the bottom of the subsurface soil distribution medium and seasonally saturated soils, no back-ups of sewage into the dwelling, no discharge of sewage/effluent to the ground surface or surface waters, and no imminent safety hazards. Brian L. Humpal, Inc. does not inspect plumbing or pumps prior to the first SSTS component as these are plumbing components. The performance of exterior pumps and associated components are not inspected as they are considered to be maintenance items. Additionally, no indications relative to compliance with electrical code requirements have been made. It is recommended that any other applicable plumbing, electrical, housing, etc. inspections be performed by a qualified inspection business. Sewage back-up verification is limited to observing the floor drain area and/or the information supplied by the last occupants of the building prior to inspection. Brian L. Humpal, Inc. cannot guarantee that the information given to them by the last occupants of the building prior to inspection relative to back-ups is accurate.
4. Certification of this SSTS does not warranty future use beyond the date of the inspection. Any SSTS, old or new, can become hydraulically overloaded or discharge sewage/effluent to the ground surface as a result of more people moving into the house than were previously occupying the house, improper maintenance, heavy usage, leaking plumbing fixtures, groundwater infiltration, tree roots, freezing conditions, surface drainage problems, poor initial design, poor construction practices, or unsuitable materials used in constructing the system; the system can also simply stop working because of its age. An SSTS that has been properly designed and installed, properly maintained, and used in the manner for which the system was designed can be expected to provide service for twenty to twenty-five years on average. Some parts of the SSTS such as alarms, switches, pumps, filters, etc. will most likely have to be repaired or replaced over the lifetime of the system.
5. A Compliance Inspection is not meant to be a test or inspection for longevity of the system; a Compliance Inspection is strictly for the purpose of determining if the SSTS is protective of public health and safety, as well as the groundwater at the date and time the inspection was performed. This inspection is not intended to determine if the SSTS was originally designed or installed to past or present MPCA or other Local Government Unit code requirements. This inspection is not intended to determine if the SSTS was designed and/or installed to support the anticipated flow from the building as the use of the building may have changed since the design and construction of the SSTS due to the addition of bedrooms, occupants, etc. In addition, this inspection is not intended to determine the quality of the original SSTS design, the quality of the construction practices used while installing the SSTS, or the quality of the materials used in constructing the SSTS.
6. Brian L. Humpal, Inc. cannot guarantee the performance of SSTS products/components such as: gravelless pipe, chamber trenches, effluent filters, tanks, sewage pre-treatment components, piping, etc. Products such as gravelless pipe are no longer approved for installation in the State of Minnesota and may have a significantly reduced performance and/or life expectancy.
7. WINTER WORK: By accepting this report, it is understood that inspections conducted during winter months (approximately November 1st through April 1st) are more difficult to perform because of possible snow cover and/or ground frost. SSTS components such as tanks, maintenance covers, tank inspection pipes, subsurface distribution medium inspection pipes, and soil treatment areas are more difficult or impossible to locate due to snow cover and/or ground frost. In addition, soil borings are more difficult to perform due to snow cover and/or ground frost. Brian L. Humpal, Inc. will attempt to use the same level of standards when performing work during winter periods as when performing work during non-winter periods. However, the recipient of this report understands that because of the aforementioned considerations, the same level of standards may not be possible.
8. By accepting this report, the client understands that Brian L. Humpal, Inc. will not be responsible for any monetary damages exceeding the fee for the services provided.

Subsurface Sewage Treatment Systems

Non-transferable

Business License

Midwest Sewer Services

License # L2896

License Expires: 12/22/2020

Issued: 11/26/2019

Specialty Area(s):

Installer

Maintainer

Service Provider

Advanced Designer

Advanced Inspector

Designated Certified Individual(s):

Cert #	Name	Certification Expires:
C5342	Brian L Humpal Installer, Maintainer, Serv Prov, Adv Designer, Adv Inspector	10/15/2023
C9852	Christopher R Uebe Designer, Inspector	3/4/2021



520 Lafayette Road North
St. Paul, Minnesota 55155-4194

Nick Haig, Supervisor
Certification and Training Unit