
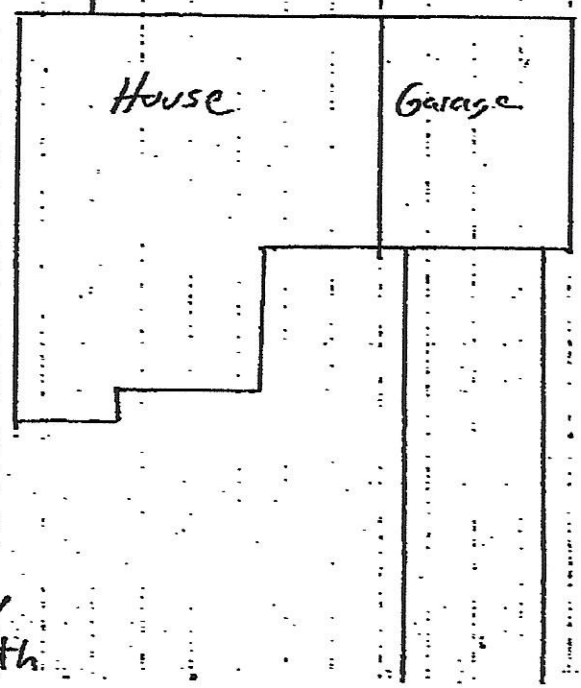
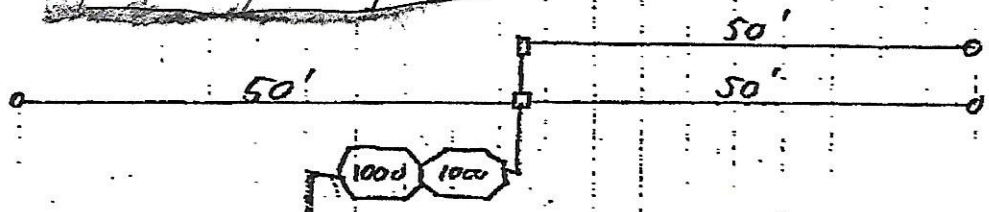


South line

120'

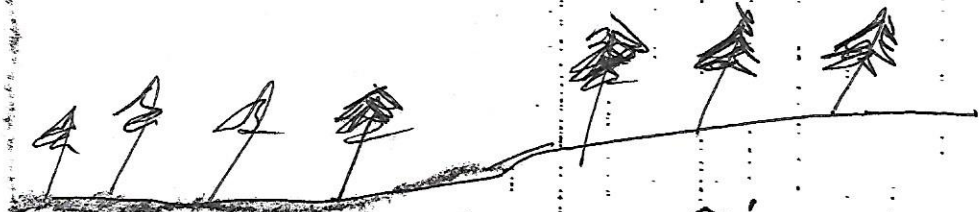

East line

303' West line

↓
North

2nd Street