


↑ N

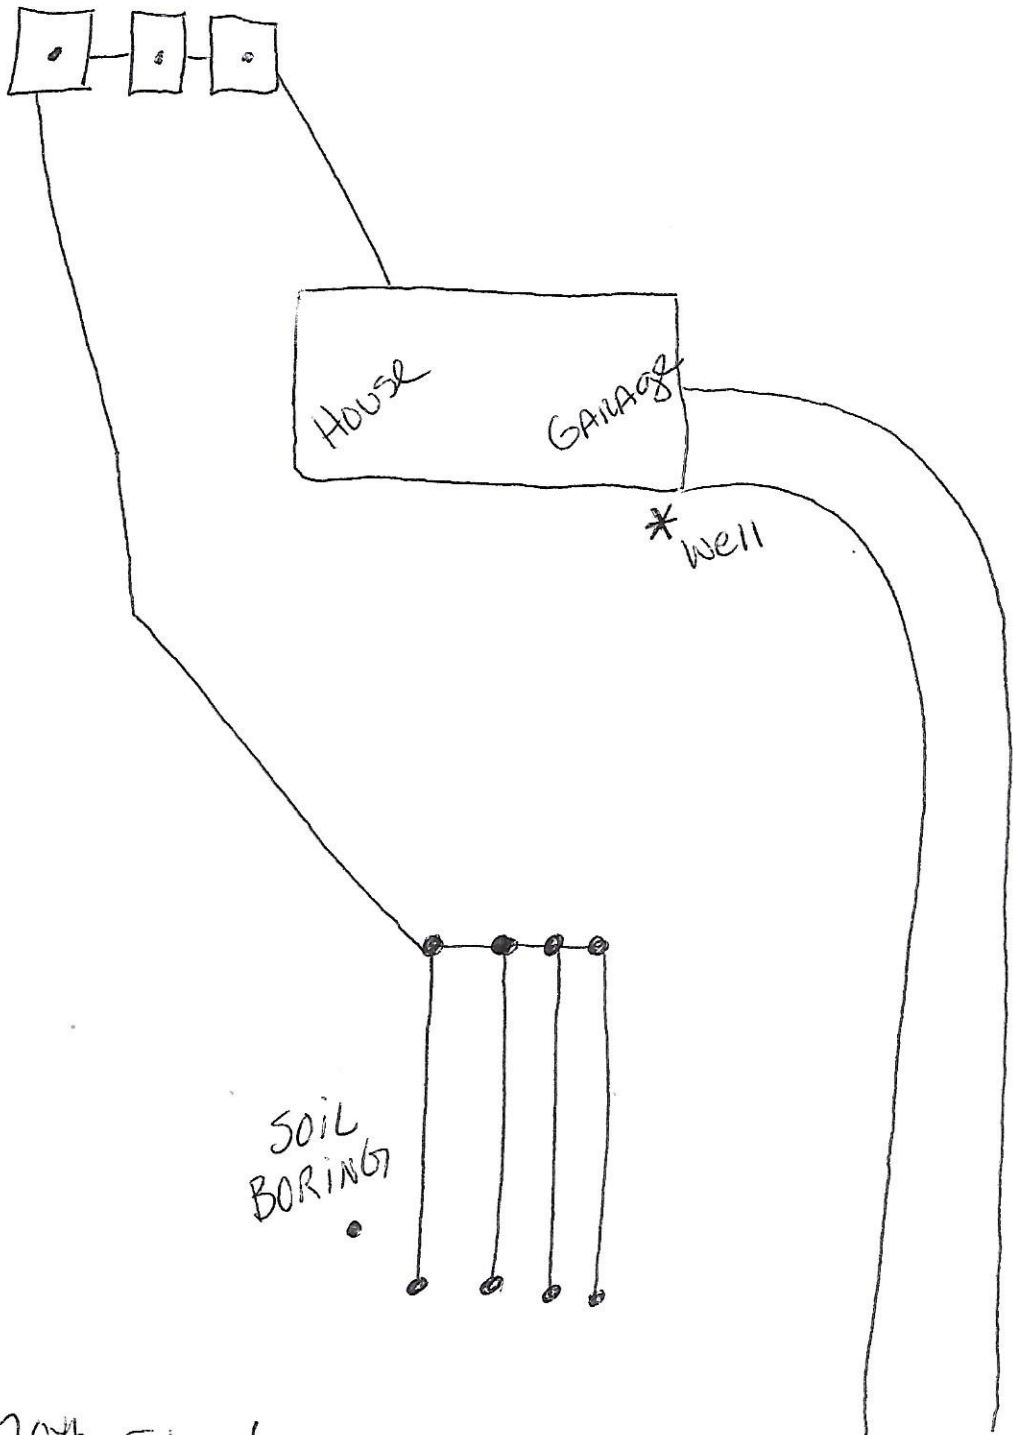

12840 20th St N