



POOL

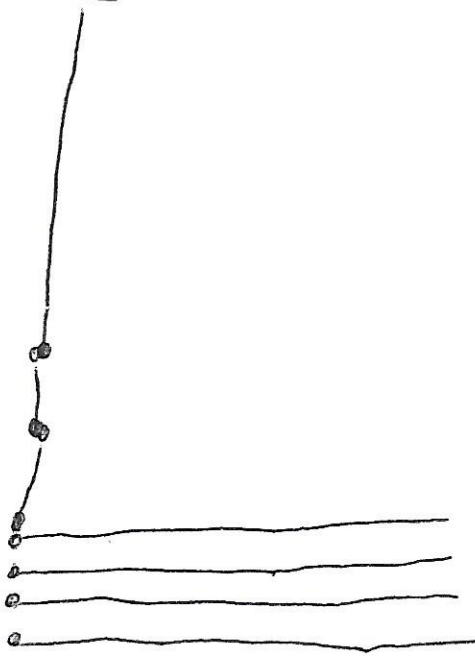

TREE LINE

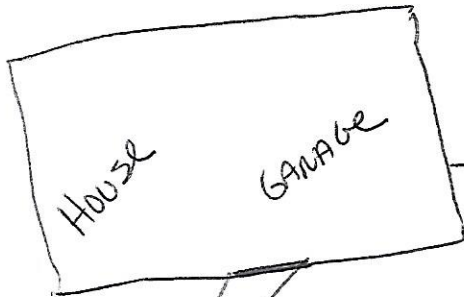

2327 MORGAN Ave N