
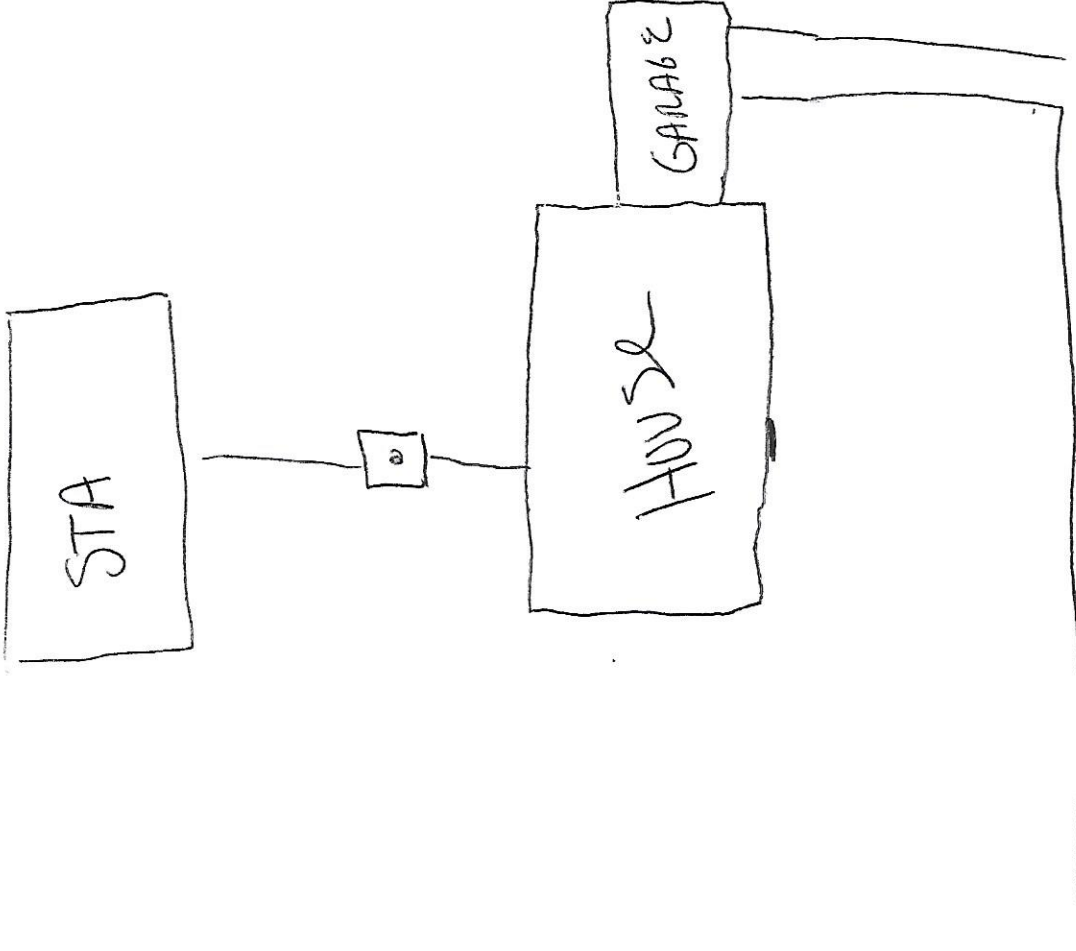


St. Croix Trail

Bike Path

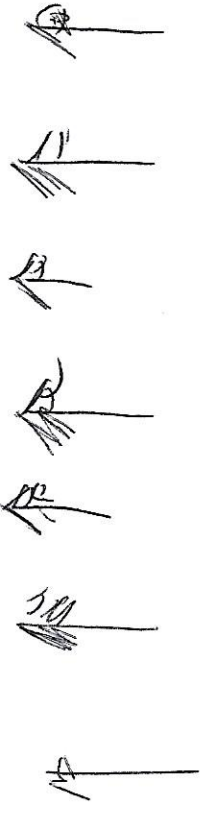

21st St. South

Property Line