


NOTE

SERVICE ONCE A YEAR:

1987 SYSTEM

1250 SEPTIC

1000 PUMP TANK

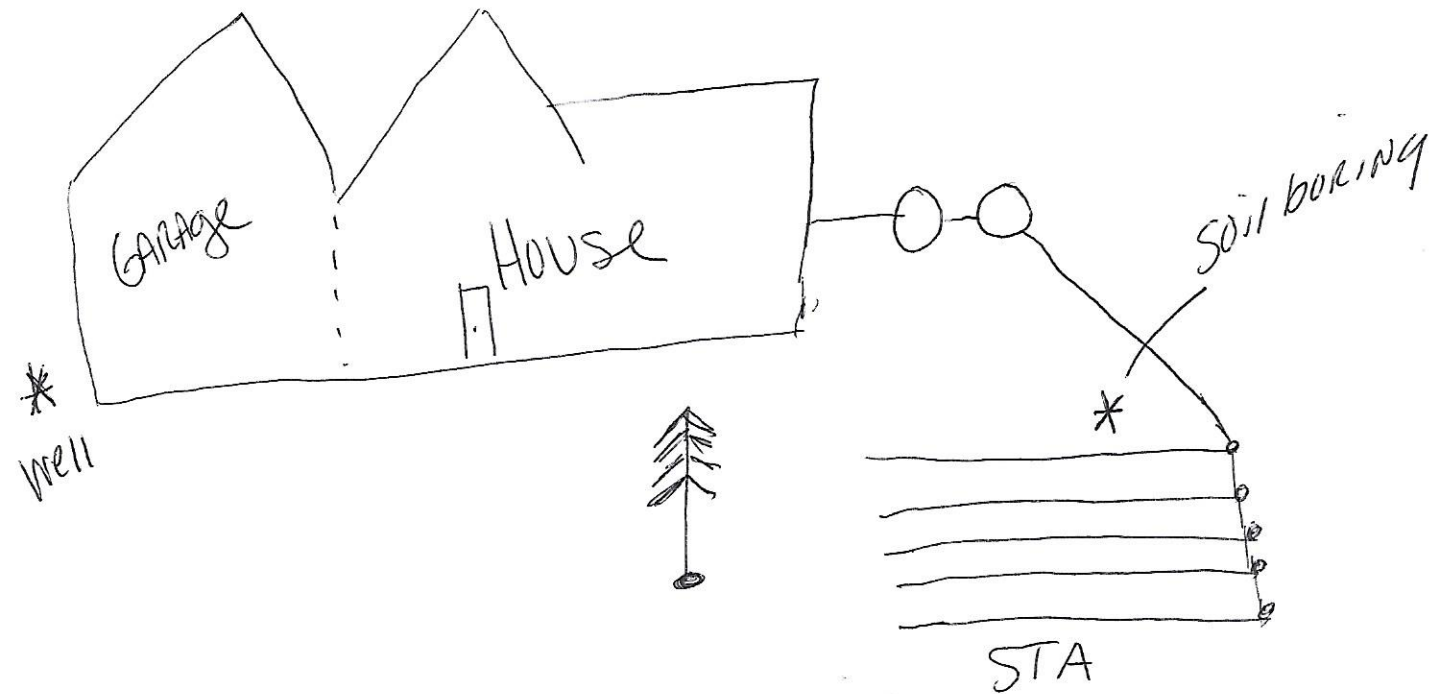

4720 Wild CANYON TR.

WDBY, MN