


↖ N

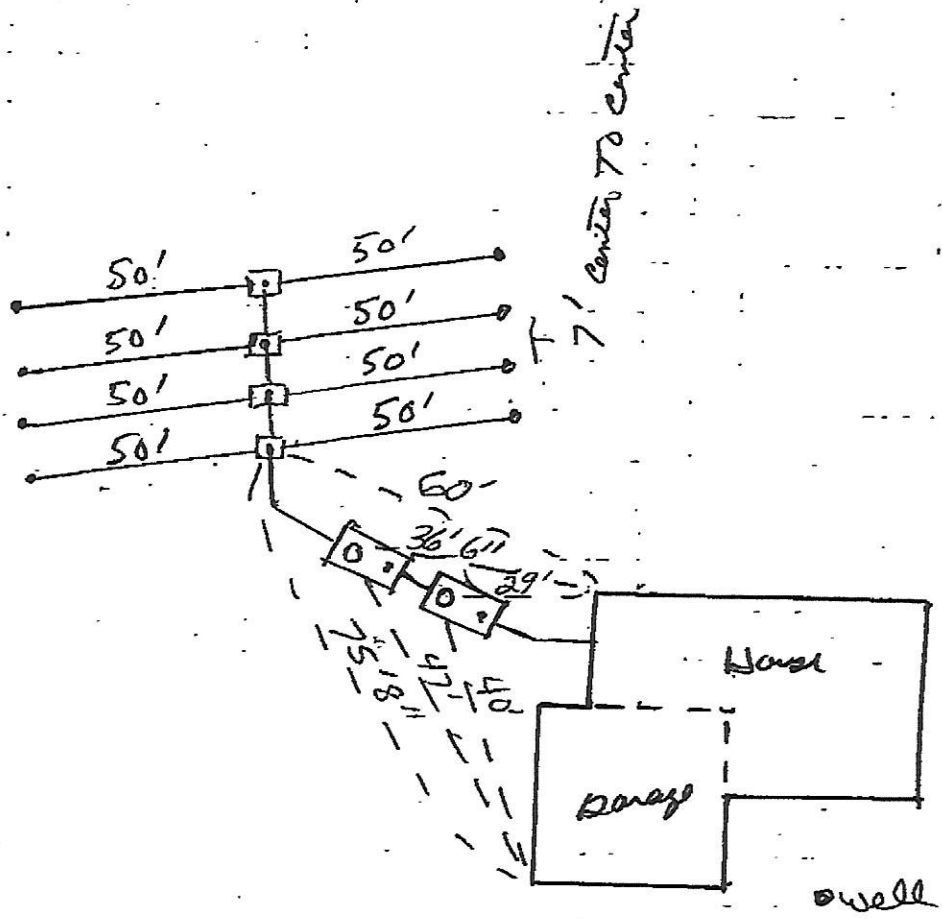

DENMARK TWP

5277 68th St S