


11751 120th St S.
Denmark Twp

7-8-04

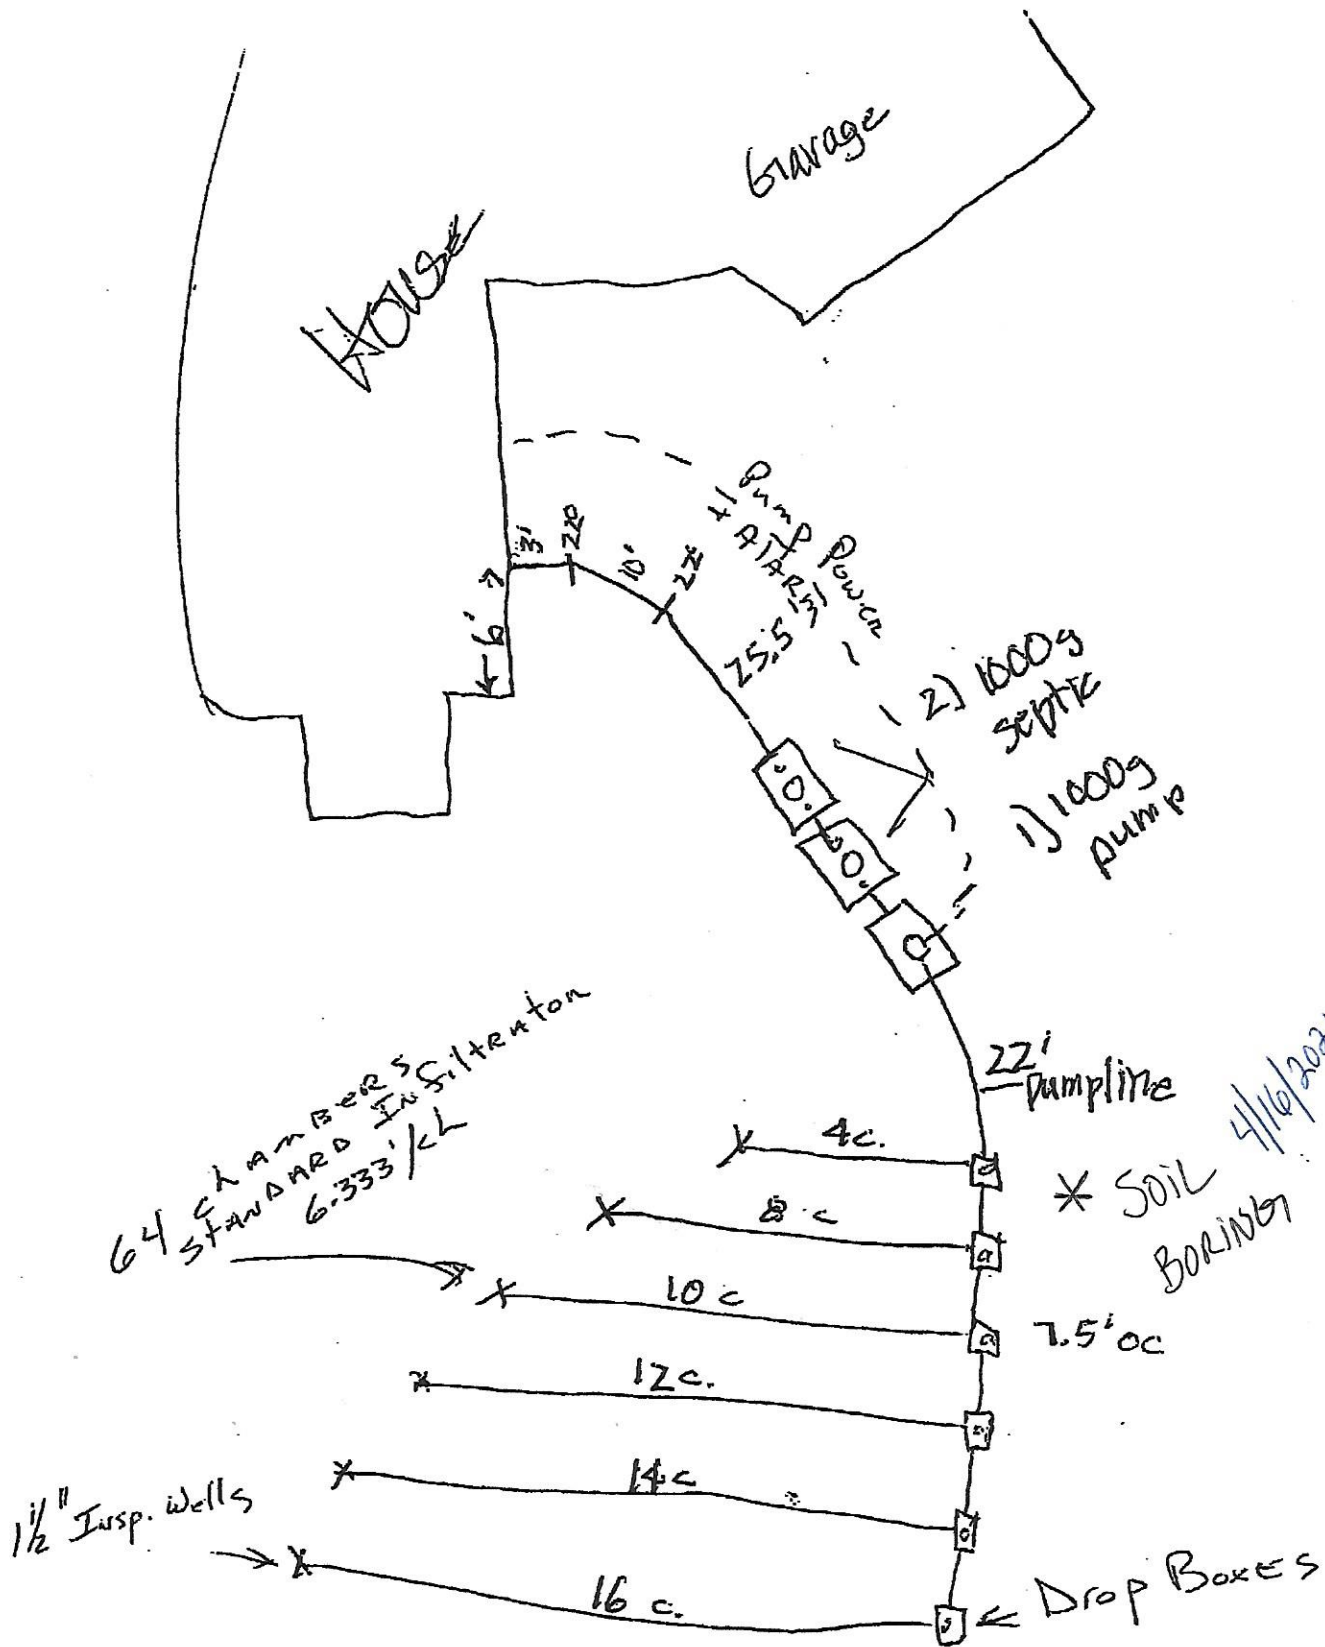

RESERVE

RESERVE