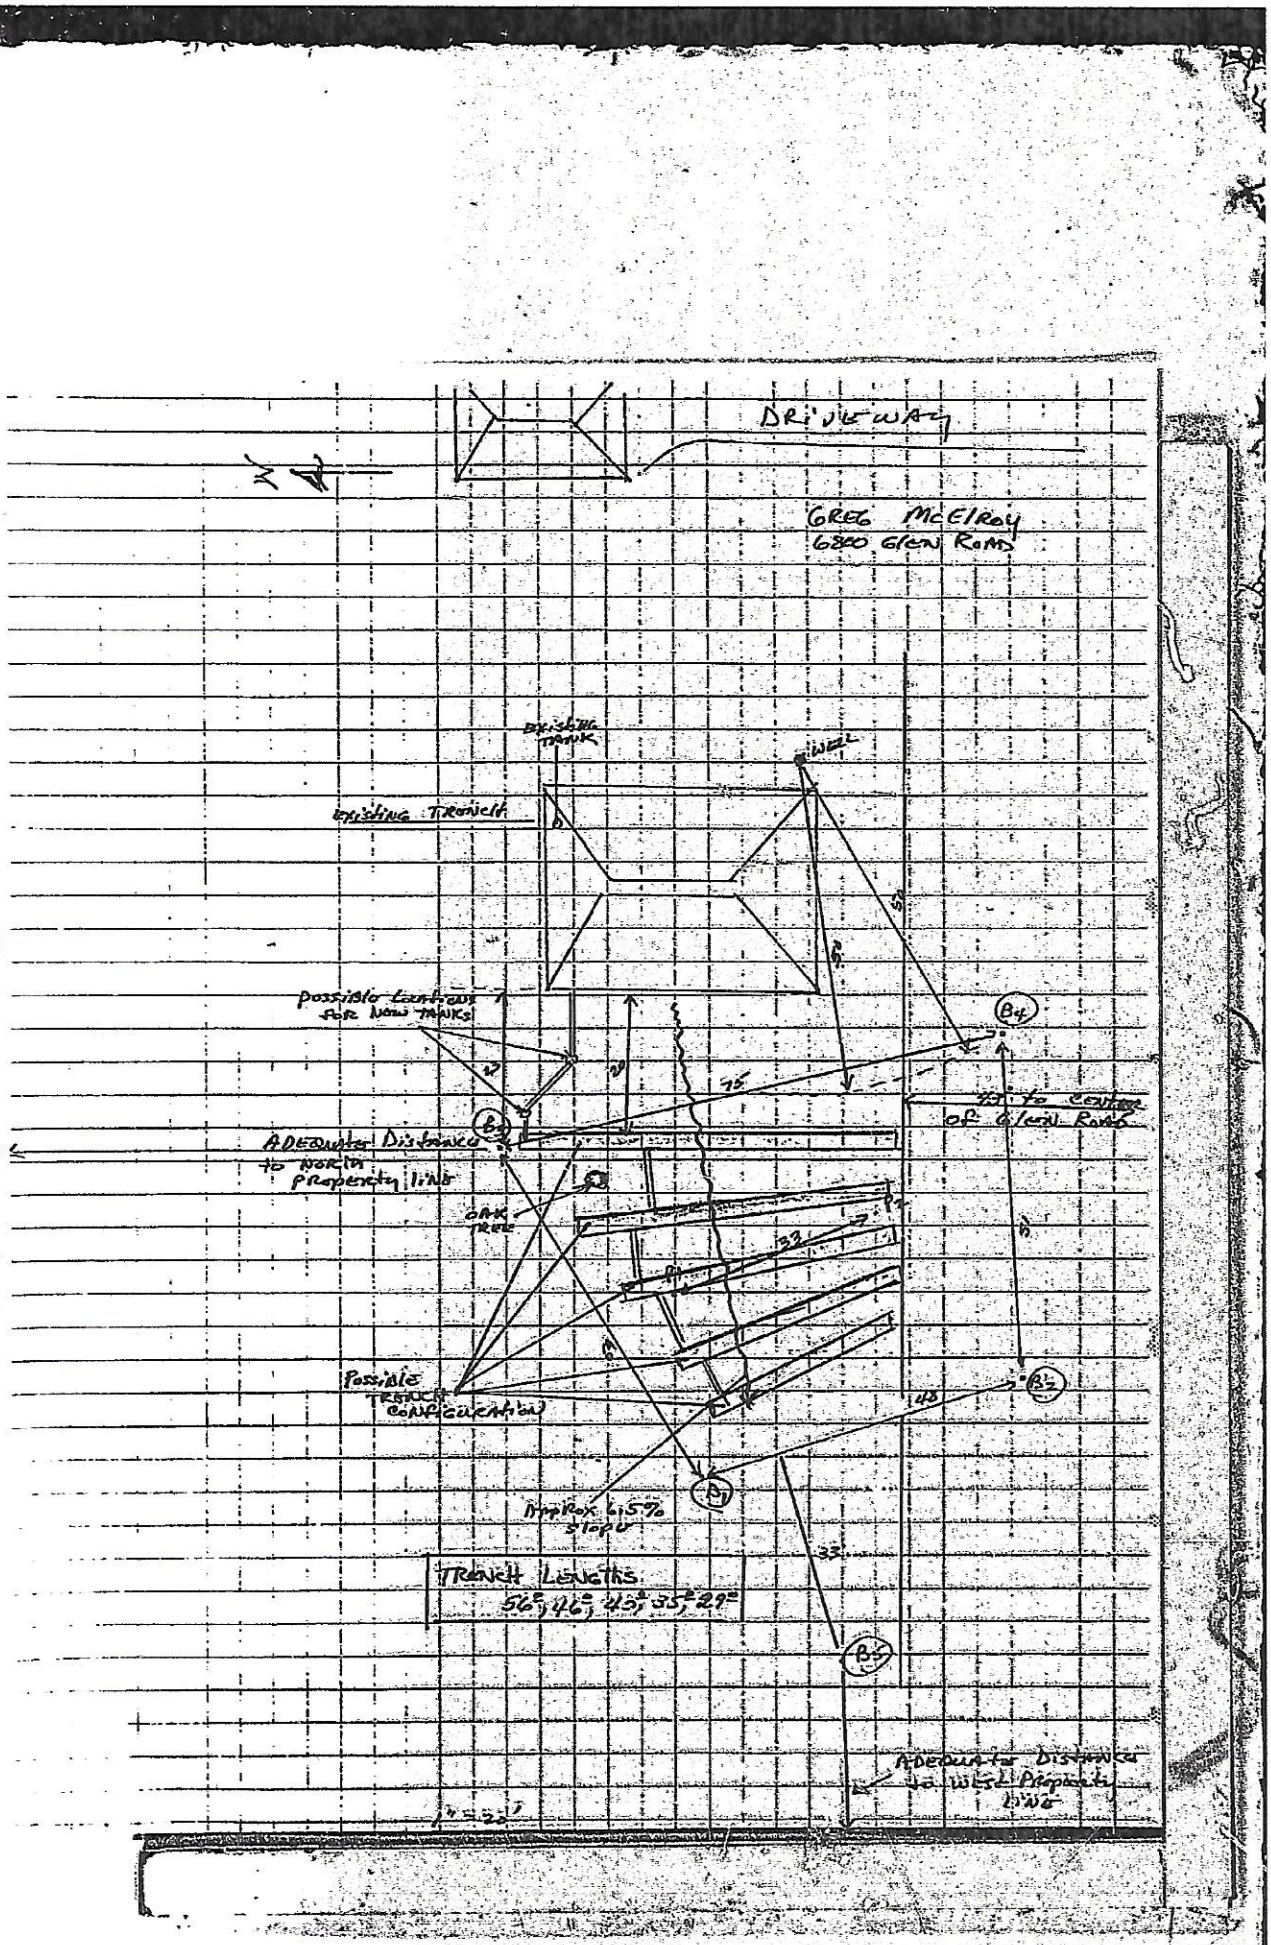
DRIVEWAY
GREG McELROY
6800 GLEN ROAD
EXISTING TANK
WELL
EXISTING TRENCH
POSSIBLE LOCATIONS FOR NEW TANKS
ADEQUATE DISTANCE TO NORTH PROPERTY LINE
OAK TREE
POSSIBLE TRENCH CONFIGURATION
APPROX 4.5% SLOPE
TRENCH LENGTHS
56'; 46'; 45'; 35'; 29'
ADEQUATE DISTANCE TO WEST PROPERTY LINE
B1
B2
B3
B4
B5
75'
33'
45'
32'
1" = 30'