

* Note: This Drawing is Not a Survey

* Land owner must disclose all wells within 100' of treatment area

* Maximum liability is limited to the cost of the site evaluation

ELEVATIONS:

BENCHMARK = ELECTRICAL IN HOUSE GRADE = 100'

SE CORNER BED = 99.33'

SW CORNER BED = 99.53'


NE CORNER BED = 98.58'

NW CORNER BED = 98.55'

PERC = 99.53'

PIT 1 = 99.52'

COVER: .5' NORTH END
1.5' SOUTH END

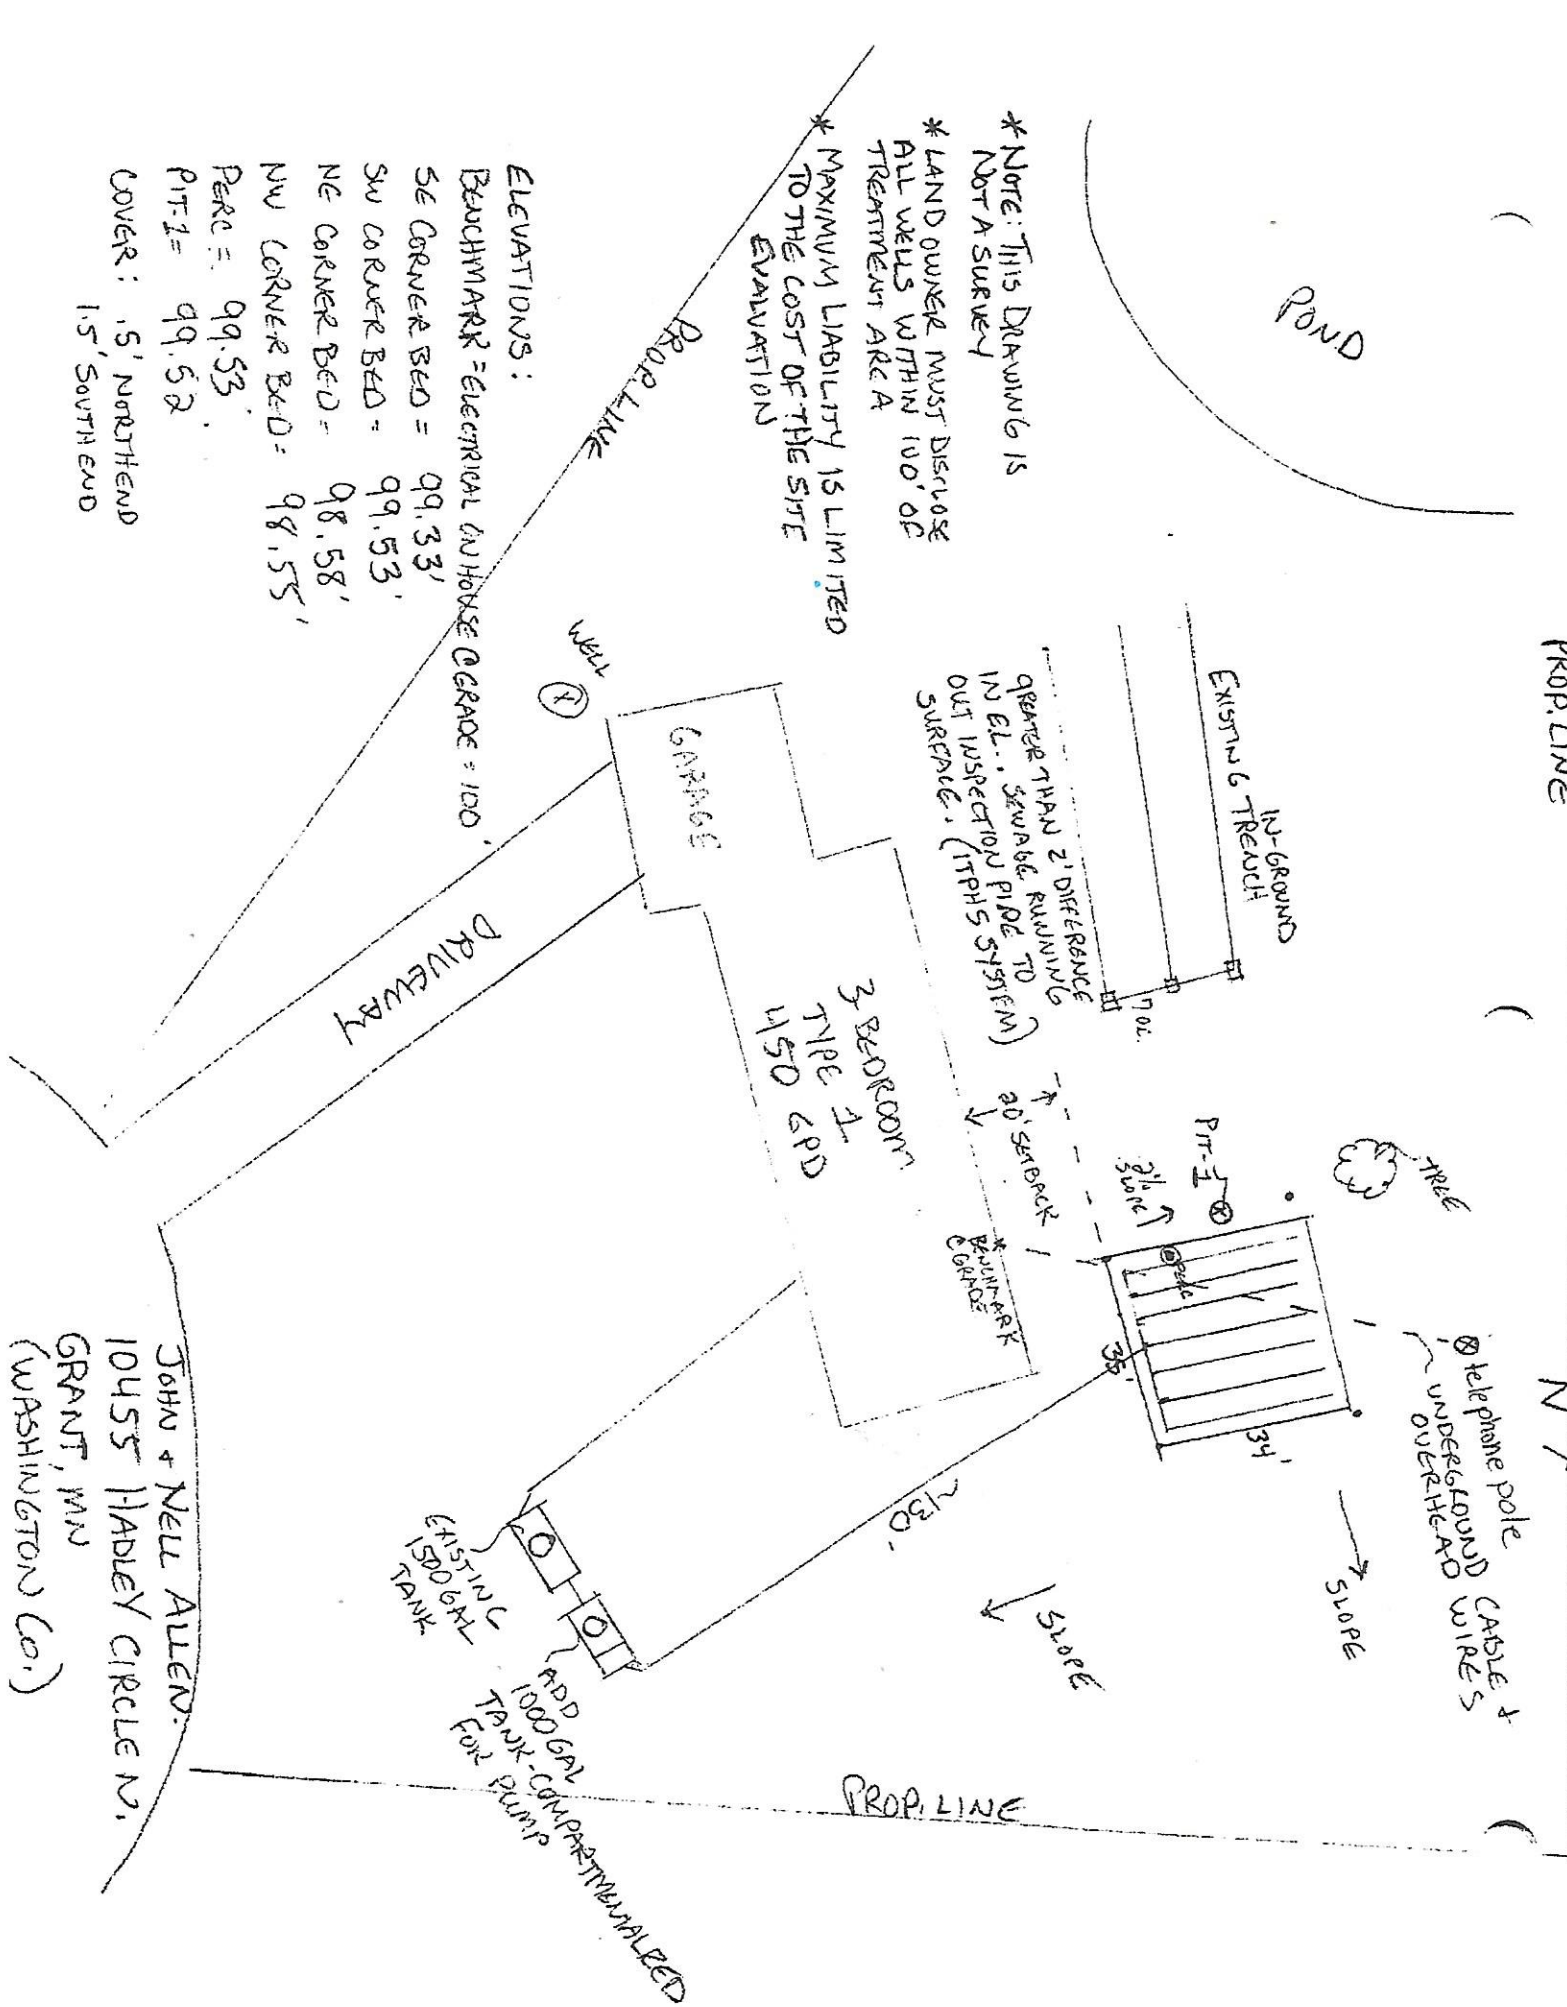

JOHN & NELL ALLEN
10455 HADLEY CIRCLE N.
GRANT, MN
(WASHINGTON CO.)