


BRENT LIBBY

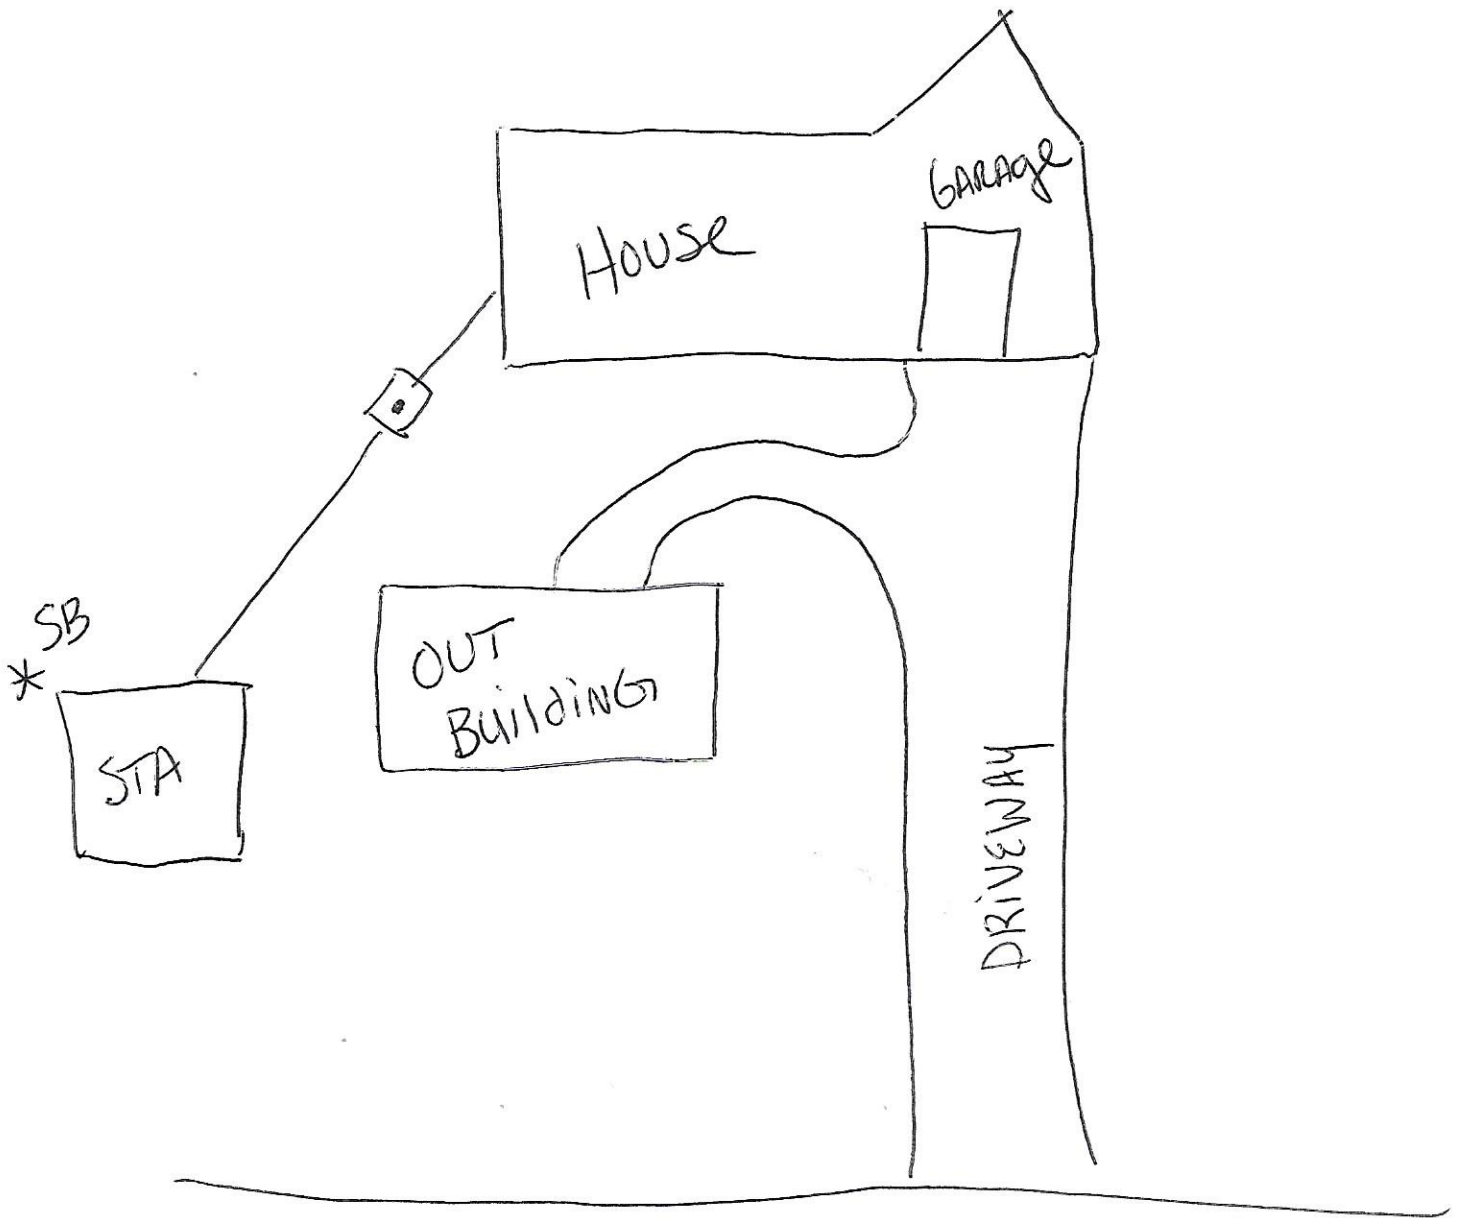

1005 BAILEY Rd