



9066 31st St
Lake Elmo, Mo.

2
3
10
11

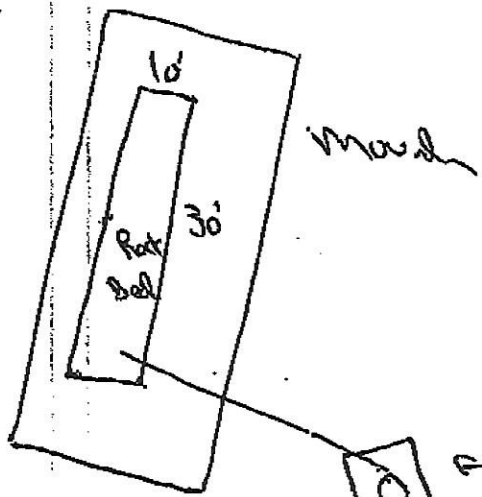

← 1000 Gal. Pump Tank

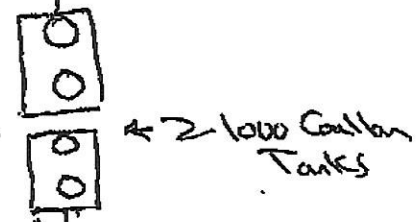

← 2 1000 Gallon Tanks

Set 40
PVC PIPE

