


← RIVER →

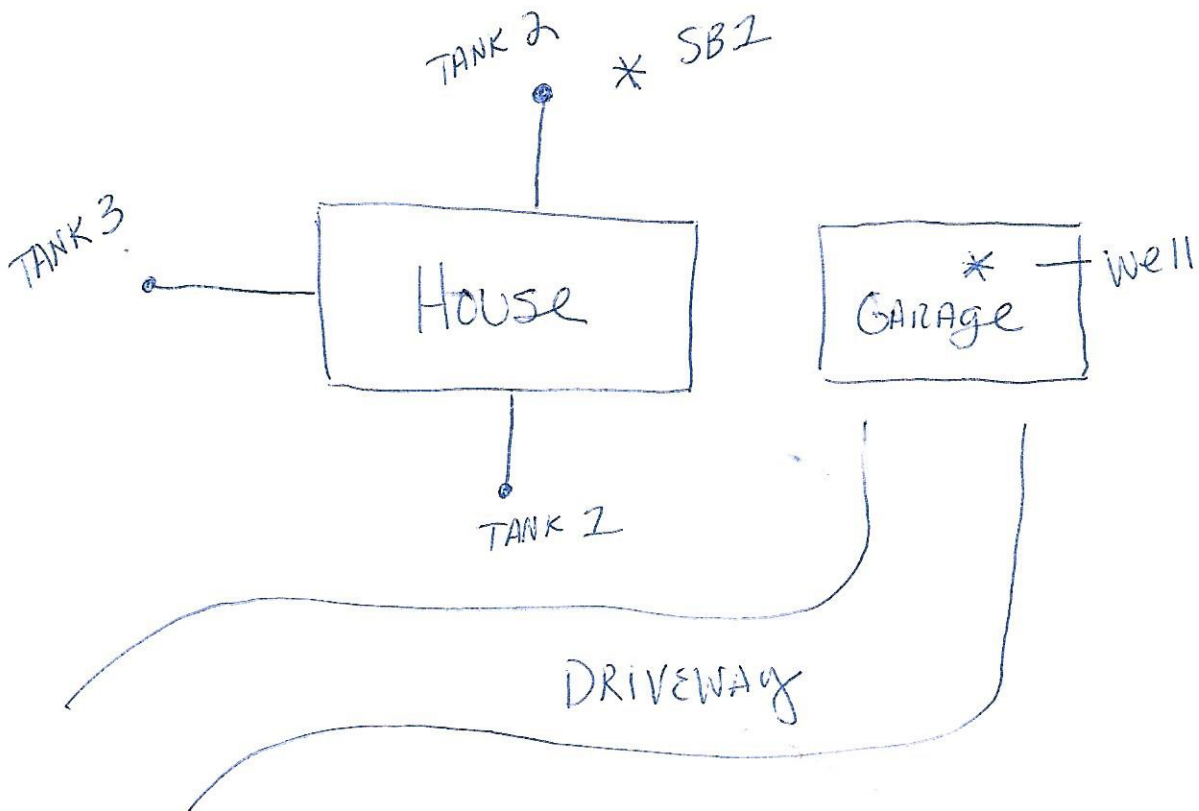

9767 GREY CLOUD ISLAND DR. S.