

J.A. CHAVES EXCAVATING
 1077 Omaha Avenue North
 STILLWATER, MINNESOTA 55082
 (612) 436-7732 or 436-7899


JOB JEFFERSON HOMES

STREET NO. PERMIT # 9893067 OF _____

CALCULATED BY J CHAVES DATE _____

CHECKED BY # 815 DATE _____

SCALE 1" = 20'

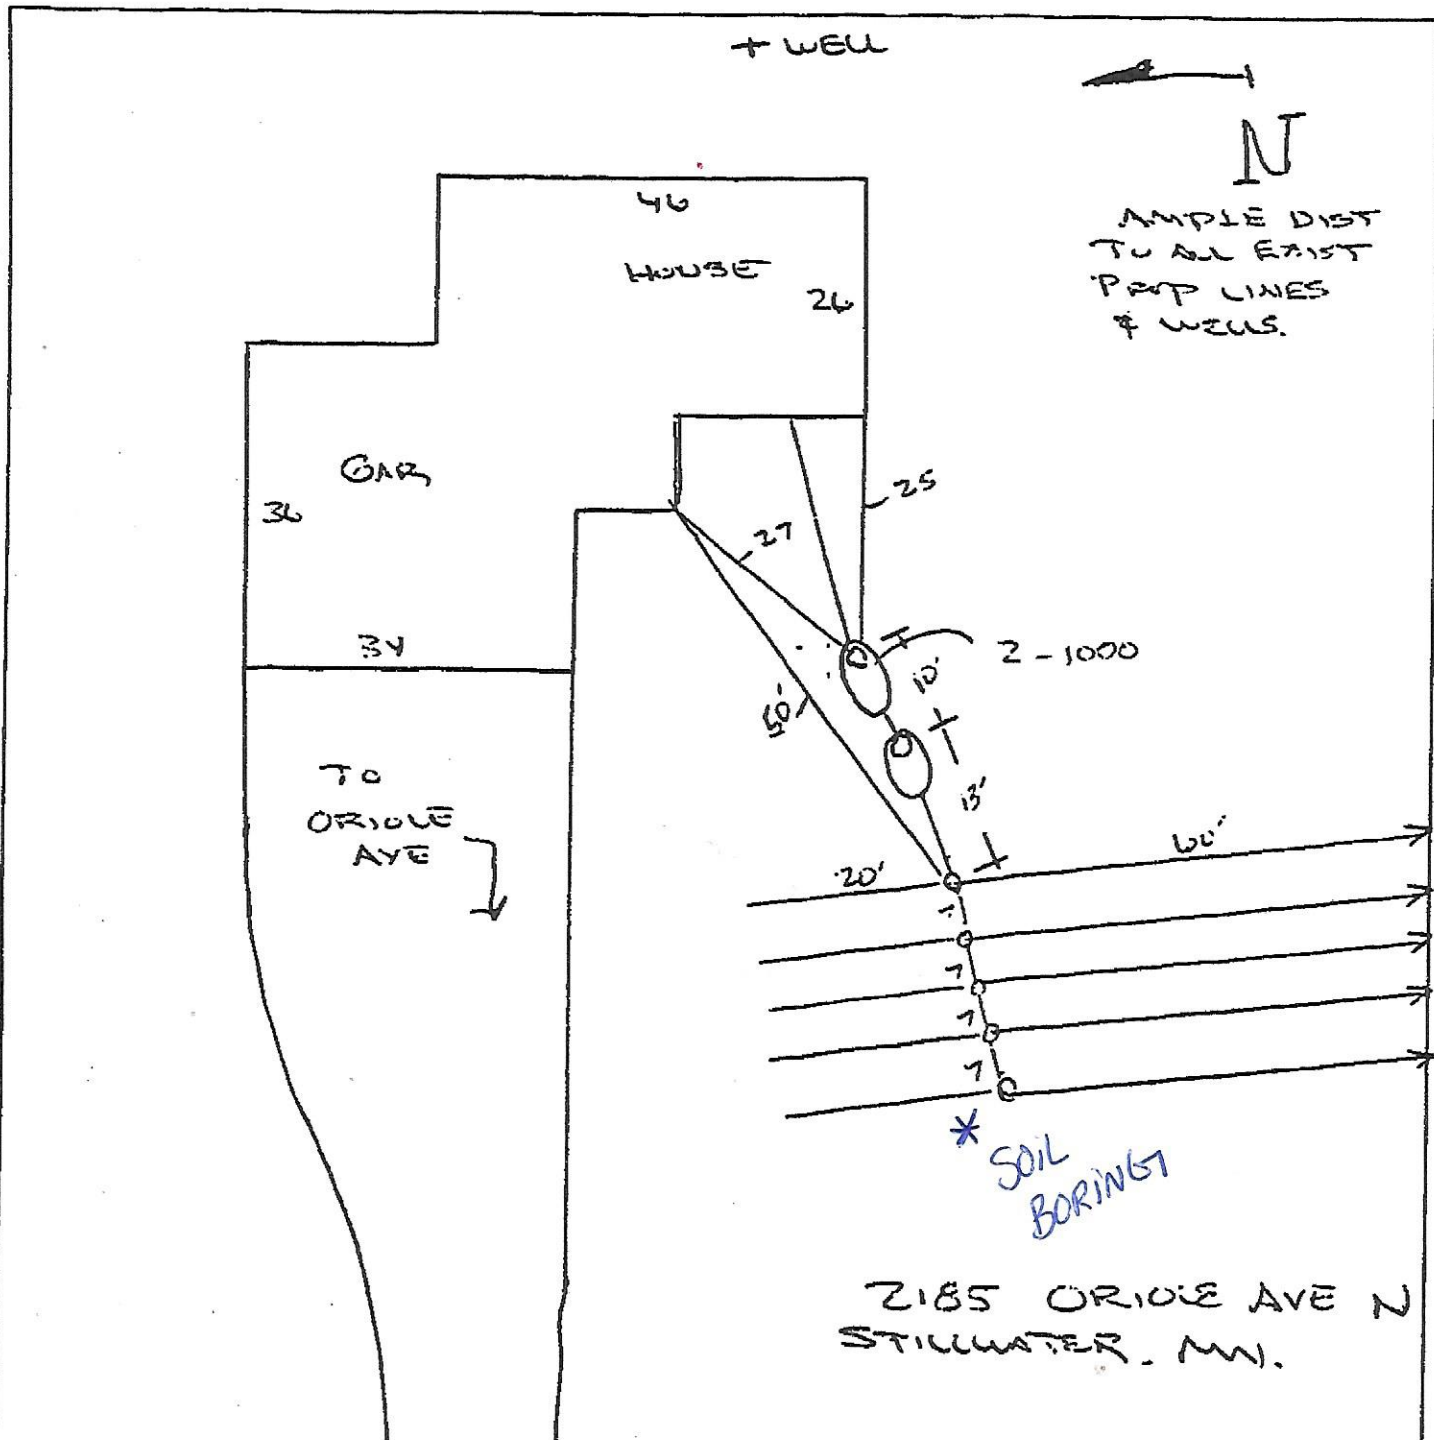

2185 ORIOLE AVE N
 STILLWATER, MN.